

USDA-FORREST SERVICE

Index
File No. C-25

CORNER RECORD (SEARCH)
(Ref. FSM 7151.4)


Tract or Survey No. _____
Cor. No. 1/4

T 6S R. 30E
Merid. WILLAMETTE

R.D. UKIAH County UMATILLA
N.F. UMATILLA State OR

CORNER DIAGRAM

DESCRIBE CORNER MONUMENT FOUND

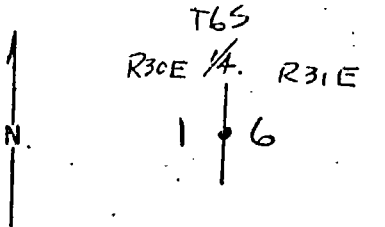

NONE

DESCRIBE BEARING TREES OR OTHER OFFICIAL ACCESSORIES FOUND

A 12" FIR STUMP BEARS N65°W 7.3 FT ALE MKS VISIBLE
A DEAD & DOWN 5" FIR BR. S65°E 130 FT MKD 1/4S BT
THIS TREE HAS SLID DOWN HILL

PHOTO IDENTIFICATION DATA
Photo No. _____
Filed At. _____
Object Ident. _____
Ident. By _____
Signature _____

DESCRIBE CORNER LOCATION RELATIVE TO NEAR-BY FEATURES, ALSO HOW TO REACH CORNER

COR IS 55 FT. SOUTH OF DRY CREEK BED

PLANE COORDINATE POSITION DATA
State _____ Zone _____
X _____
Y _____
Estob. By _____
Agency _____

Signature _____ Title _____ Division _____ Headquarters _____ Date _____
7100-52 (3 68)

CORNER RECORD (PERPETUATION)

C-25 / C-1

GPO 802-478

MONUMENT. DESCRIBE NEW MONUMENT SET, OR WORK DONE TO PRESERVE EXISTING MONUMENT

SET 2 1/2" X 30" IRON PIPE MKD

T65
 1/4
 R30E | R31E
 S1 | S2
 1976
 OPL5598

ACCESSORIES DESCRIBE NEW BT'S WITNESS OBJECTS ETC. ESTABLISHED, OR WORK DONE TO PRESERVE EXISTING EVIDENCE

NEW BT'S:

A 6" FIR BRG N41°E 28 1/2 FT. MKD T65 R31E 1/4 S6 BT.
 A 10" FIR " S8°W 19 1/2 " " T65 R30E 1/4 S1 BT.

Work Done By R.D. Baggett Title LAND SURVEYOR Date 9-30-76 State Registration No. OPL5 598
 or Agency

Certified Cor Record Prepared? Yes No Filed At CHATILLA C.S. Date

REMARKS

Index File No. 1

T.

R.

M.

Tract or Surv. No

Cor.