


Index File No. E-25
T. 65 R. 30E
Merid. W.M.

CORNER RECORD (SEARCH)
(Ref. FSM 7151.4)

Tract or Survey No. _____
Cor. No. E-25

R.D. UKIAH County UMATILLA
N.F. UMATILLA State ORE.

CORNER DIAGRAM

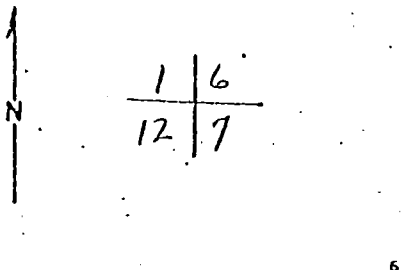

DESCRIBE CORNER MONUMENT FOUND

Found basalt stone 16"x9"x8" mkd with 5 notches on S edge + 1 notch on N. edge firmly set in mound of stone

DESCRIBE BEARING TREES OR OTHER OFFICIAL ACCESSORIES FOUND

A 20" pine brs N17°E 96± ft. mkd TB

PHOTO IDENTIFICATION DATA

Photo No. _____
Filed At. _____
Object Ident. _____
Ident. By _____
Signature

DESCRIBE CORNER LOCATION RELATIVE TO NEAR-BY FEATURES, ALSO HOW TO REACH CORNER

PLANE COORDINATE POSITION DATA

State _____ Zone _____
X _____
Y _____
Estab. By _____
Agency

Signature _____ Title _____ Division _____ Headquarters _____ Date 9-30-76 7100-52 (3 63)

CORNER RECORD (PERPETUATION)

E. 25th St

MONUMENT. DESCRIBE NEW MONUMENT SET, OR WORK DONE TO PRESERVE EXISTING MONUMENT

Set 2 1/2" x 30" iron pipe with brass cap mkd.
 Raised mound of stone 4 ft. base to top of pipe.

T65
 R30E R31E
 S1 | 56
 S12 | 57
 1276
 CP 5598

ACCESSORIES. DESCRIBE NEW BT'S WITNESS OBJECTS ETC. ESTABLISHED, OR WORK DONE TO PRESERVE EXISTING EVIDENCE

NEW BTA

A 11" PINE BR5 S36°E 431 FT. MKD T65 R31E S1 BT.
 A 10" " " S30°W 464 FT " T65 R30E S12 BT.
 A 12" " " N54°W 140 FT " T65 R30E S1 BT

Work Done By R.D. Bayett Title LAND SURVEYOR Date 9-30-76 State Registration No. or Agency OPLS 598

Certified Copy Record Prepared? Yes No Filed At WATILLA CO. SURVEYOR Date

REMARKS

WITNESS TO CORNER:
 WALT GENTIS

Index
File No. E-1


CORNER RECORD (SEARCH)
(Ref. FSM 7151.4)

Tract or Survey No. _____
Cor. No. E-1 SEC

T 65 R. 34-E
Merid. Willamette

R.D. UKIAH County UMATILLA
N.F. UMATILLA State OR

CORNER DIAGRAM

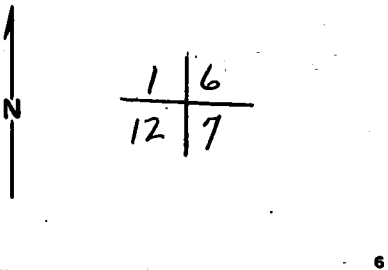

DESCRIBE CORNER MONUMENT FOUND

Found basalt stone 16" x 9" x 8" mkd with 5 notches on S. edge + 1 notch on N. edge firmly set in mound of stone

DESCRIBE BEARING TREES OR OTHER OFFICIAL ACCESSORIES FOUND

A 20" pine brs N17°E 96± ft. mkd T6

PHOTO IDENTIFICATION DATA

Photo No. _____
Filed At. _____
Object Ident. _____
Ident. By _____
Signature

DESCRIBE CORNER LOCATION RELATIVE TO NEAR-BY FEATURES, ALSO HOW TO REACH CORNER

PLANE COORDINATE POSITION DATA

State _____ Zone _____
X _____
Y _____
Estab. By _____
Agency

Signature
R.D. Smith

Title ORLS Division _____ Headquarters _____ Date 9-30-76
7100-52-(3/68)

CORNER RECORD (PERPETUATION)

MONUMENT: DESCRIBE NEW MONUMENT SET, OR WORK DONE TO PRESERVE EXISTING MONUMENT

Set 2 1/2" x 30" iron pipe with brass cap mkd.
 Raised mound of stone, 4 ft. base to top of pipe.

T65
 R30E R31E
 S1 | S6
 S12 | S7
 1976
 OPLS 598

9

ACCESSORIES: DESCRIBE NEW BT'S WITNESS OBJECTS ETC. ESTABLISHED, OR WORK DONE TO PRESERVE EXISTING EVIDENCE

NEW BTs

A 11" PINE BR3 S36°E 431 FT. MKD T65 R31E S7 BT.
 A 10" " " S30°W 464 FT " T65 R30E S12 BT.
 A 12" " " N54°W 140 FT " T65 R30E S1 BT

10

Work Done By R.D. Baggett Title LAND SURVEYOR Date 9-30-76 State Registration No. OPLS 598
 or Agency

Certified Cor. Record Prepared? Yes No Filed At: UMATILLA CO. SURVEYOR Date

11

REMARKS

WITNESS TO CORNER:

WALT GENTIS

12

Index File No. E-1 T. R. M. Tract or Surv. No. Cor. 13