


Index E-7
 File No. _____
 T 6S R. 31E
 Merid. _____

CORNER RECORD (SEARCH)
 (Ref. FSM 7151.4)
 R.D. Ukiah County Umatilla
 N.F. Umatilla State Oregon

Tract or Survey No. _____ No. E-7

CORNER DIAGRAM

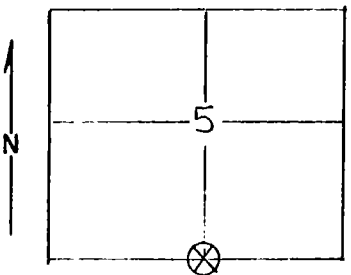

DESCRIBE CORNER MONUMENT FOUND

A pile of stones 2'x2'x1' in size 8" above grd. in poor condition.
 There were no markings. Original was a post.

DESCRIBE BEARING TREES OR OTHER OFFICIAL ACCESSORIES FOUND

Found a pine 19" DBH 17 IKS that has been chopped out, showing good scribing. Painted 6" red band and also painted scribing. Attached proper signs to tree. Put one steel post up at the corners approx. location. With two signs attached to it. An attention and property boundary sign.

PHOTO IDENTIFICATION DATA

Photo No. _____
 Filed At. _____
 Object Ident. _____
 Ident. By _____
Signature

DESCRIBE CORNER LOCATION RELATIVE TO NEAR-BY FEATURES, ALSO HOW TO REACH CORNER

PLANE COORDINATE POSITION DATA

State _____ Zone _____
 X _____
 Y _____
 Estab. By _____
Agency

Signature
MLC

Title
For Tech

Division
USFS

Headquarters
Ukiah

Date
4/20/78

1
2
3
4
5