

Index
File No. G-25

CORNER RECORD (SEARCH)

(Ref. FSM 7151.4)

Tract or
Survey No. _____ No. _____


T 6S R. 30E

R.D. UKIAH County UMATILLA

Merid. WILLAMETTE

N.F. UMATILLA State OREGON

CORNER DIAGRAM

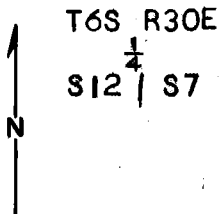

DESCRIBE CORNER MONUMENT FOUND

MOUND OF STONES IN WRONG POSITION BY APX. 25'

DESCRIBE BEARING TREES OR OTHER OFFICIAL ACCESSORIES FOUND

40" PINE N08E 43.6' NOW STUMP WITH SCRIBING VISIBLE
26" PINE S17W 9.9' SCRIBING VISIBLE

PHOTO IDENTIFICATION DATA

Photo No. _____
Filed At. _____
Object Ident. _____
Ident. By _____
Signature

DESCRIBE CORNER LOCATION RELATIVE TO NEAR-BY FEATURES, ALSO HOW TO REACH CORNER

THERE IS A LOCATION TAG APX. 1000' SOUTH OF CORNER
ON OLD ROAD.

PLANE COORDINATE POSITION DATA

State _____ Zone _____
X _____
Y _____
Estab. By _____
Agency

M.D. Harris
Signature

Title _____ Division _____ Headquarters _____ Date _____

CORNER RECORD (PERPETUATION)

MONUMENT: DESCRIBE NEW MONUMENT SET, OR WORK DONE TO PRESERVE EXISTING MONUMENT

SET A 2"x30" IRON PIPE WITH A BRASS-CAP MARKED:

CORNER MONUMENT IS SET IN MOUND OF STONES.

T 16830
B30E3R31E
1
+4
S12 S7
1978
PLS 346

ACCESSORIES : DESCRIBE NEW BT'S WITNESS OBJECTS ETC. ESTABLISHED, OR WORK DONE TO PRESERVE EXISTING EVIDENCE

10" PINE ~~3865~~ 27.2' MARKED: 1/4 S7 BT

THE PINE STUMP HAS A BEARING TREE TAG. THE OLD AND NEW BT'S HAVE A RED PAINTED STRIPE, BEARING TREE TAGS, AND AN ATTENTION SIGN. THE NEW BT HAS A BRASS WASHER STAMPED PLS 346 NAILED TO THE LOWER BLAZE. THERE IS A FENCE POST ON LINE WITHIN 5' OF THE CORNER.

Work Done By W.O. HARRIS

Title _____

Date _____

State Registration No. PLS 346
or Agency _____

Certified Cor. Record Prepared ? Yes

No

Filed At: _____

Date _____

REMARKS

Index File No.

T.

R.

M.

Tract or Surv. No.

Cor.

12

13

USDA-FOREST SERVICE

Index File No. G-25
 T 6S R. 30E
 Merid. Will.


CORNER RECORD (SEARCH)

(Ref. FSM 7151.4)

Tract or Survey No. _____ No. G-25

R.D. Ukiah County Umatilla
 N.F. Umatilla State Oregon

CORNER DIAGRAM

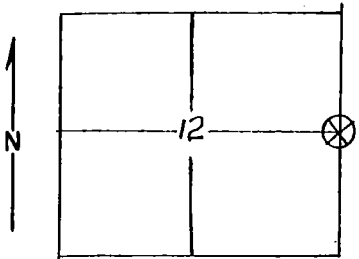

DESCRIBE CORNER MONUMENT FOUND

None

DESCRIBE BEARING TREES OR OTHER OFFICIAL ACCESSORIES FOUND

Found one ponderosa pine 22" DBH. Has been chopped a long time ago. It has good visible 4 & part of S. This bears S17°N 15 lks from corner. Painted a 6" red band and also scribing put Bt tag on north side and an attention sign on south side. Found a stump bearing N8°E. It has a scar facing corner with part of scribing visible (1). At this stump, put just an attention sign.

PHOTO IDENTIFICATION DATA

Photo No. _____
 Filed At. _____
 Object Ident. _____
 Ident. By _____
Signature

DESCRIBE CORNER LOCATION RELATIVE TO NEAR-BY FEATURES, ALSO HOW TO REACH CORNER

We put the post about 30' north of 22" pine which is not quite the right location. It has a property sign and an attention sign attached.

PLANE COORDINATE POSITION DATA

State _____ Zone _____
 X _____
 Y _____
 Estab. By _____
Agency

Signature
MLC

Title
For Tech,

Division
USFS

Headquarters
Ukiah

Date
4/19/78

7100-52-(3. 68)