


Index File No. J-13
 T 6S R. 31E
 Merid. _____

CORNER RECORD (SEARCH)
 (Ref. FSM 7151.4)

Tract or Survey No. _____ No. J-13

R.D. Ukiah County Umatilla
 N.F. Umatilla State Oregon

CORNER DIAGRAM

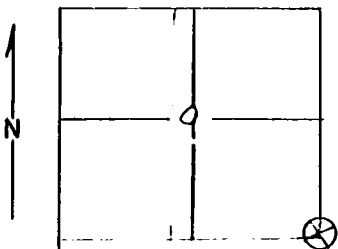

DESCRIBE CORNER MONUMENT FOUND

A stone 18"x16"x8" in size all above grd. The Condition was poor. No markings could be found; but this could possibly be the stone.

DESCRIBE BEARING TREES OR OTHER OFFICIAL ACCESSORIES FOUND

One rotten log that could have been 44" DBH. It bears S85°E 72 lks. It has two faces on it on the North side of log and almost underneath it. Nailed attention sign on top and attached a bearing tree tag above scribing of which is faintly visible. Painted scribing red and put a 6" red band around it. Put up two steel posts with two metal signs attached. Attention sign and property boundary sign.

PHOTO IDENTIFICATION DATA

Photo No. _____
 Filed At. _____
 Object Ident. _____
 Ident. By _____
 Signature _____

DESCRIBE CORNER LOCATION RELATIVE TO NEAR-BY FEATURES, ALSO HOW TO REACH CORNER

PLANE COORDINATE POSITION DATA

State _____ Zone _____
 X _____
 Y _____
 Estab. By _____
 Agency _____

Signature MLC Title For, Tech, Division USFS Headquarters Ukiah Date 4/20/78 7100-52-(3,68)