

Index File No. J-7

CORNER RECORD (SEARCH)


(Ref. FSM 7151.4)

Tract or Survey No. J-7 No. J-7

R. 6S R. 31E  
Merid. Will.

R.D. Ukiah County Umatilla  
N.F. Umatilla State Oregon

CORNER DIAGRAM

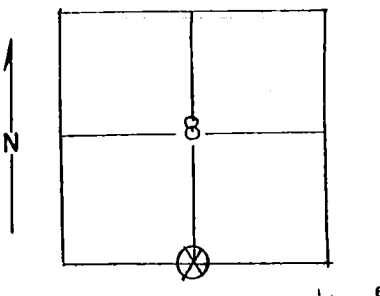

DESCRIBE CORNER MONUMENT FOUND

A stone 17"x12"x9" in size and 12" above ground in poor condition with no markings.

2

DESCRIBE BEARING TREES OR OTHER OFFICIAL ACCESSORIES FOUND

A stone in pile of stones fitting notes was found but no markings on stone. A location tag on tree 12' south was found and on 14' north. Both ~~pt.~~ have been destroyed, the one to the north by fire and the one to the south by logging.

3

PHOTO IDENTIFICATION DATA

Photo No. \_\_\_\_\_  
Filed At. \_\_\_\_\_  
Object Ident. \_\_\_\_\_  
Ident. By \_\_\_\_\_  
*Signature* \_\_\_\_\_

DESCRIBE CORNER LOCATION RELATIVE TO NEAR-BY FEATURES, ALSO HOW TO REACH CORNER

We erected a steel post to the south of stones some 3' away with attention signs and a property boundary sign attached to it. Also painted possible corner stone red.

4

PLANE COORDINATE POSITION DATA

State \_\_\_\_\_ Zone \_\_\_\_\_  
X \_\_\_\_\_  
Y \_\_\_\_\_  
Estab. By \_\_\_\_\_  
*Agency* \_\_\_\_\_

Signature  
MLC

Title  
For, Tech,

Division  
USFS

Headquarters  
Ukiah

Date  
4/19/78

7100-52-(3, 68)

5