

USDA-FOREST SERVICE

Index L-25

File No. \_\_\_\_\_

T 6S R. 30E

Merid. WILLAMETTE

CORNER RECORD (SEARCH)


(Ref. FSM 7151.4)

Tract or Survey No. \_\_\_\_\_ No. \_\_\_\_\_

R.D. UKIAH County UMATILLA

N.F. UMATILLA State OREGON

CORNER DIAGRAM

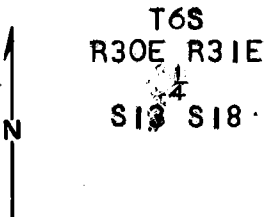

DESCRIBE CORNER MONUMENT FOUND

NONE

DESCRIBE BEARING TREES OR OTHER OFFICIAL ACCESSORIES FOUND

16" PINE S22E 32.3' SCRIBING NOT OPENED UP.

PHOTO IDENTIFICATION DATA

Photo No. \_\_\_\_\_

Filed At. \_\_\_\_\_

Object Ident. \_\_\_\_\_

Ident. By \_\_\_\_\_

*Signature*

PLANE COORDINATE POSITION DATA

State \_\_\_\_\_ Zone \_\_\_\_\_

X \_\_\_\_\_

Y \_\_\_\_\_

Estab. By \_\_\_\_\_

*Agency*

DESCRIBE CORNER LOCATION RELATIVE TO NEAR-BY FEATURES, ALSO HOW TO REACH CORNER

THERE IS A LOCATION TAG APX. 1200' SOUTH OF CORNER ON OLD ROAD. TO REACH CORNER, CROSS FENCE AND DRIVE-WALK.

*M.D. Davis*

*Signature*

Title

Division

Headquarters

Date

7100-52-(3/68)

CORNER RECORD (PERPETUATION)

MONUMENT: DESCRIBE NEW MONUMENT SET, OR WORK DONE TO PRESERVE EXISTING MONUMENT

SET A 2"x30" IRON PIPE WITH A BRASS-CAP MARKED: T6S  
R30E R31E  
1/4  
S13 S18  
1978 PLS 346

ACCESSORIES: DESCRIBE NEW BT'S WITNESS OBJECTS ETC. ESTABLISHED, OR WORK DONE TO PRESERVE EXISTING EVIDENCE

14" FIR S36W 7.5' MARKED: 1/4 S13 BT

BOTH BT'S HAVE A RED-PAINTED STRIPE, BEARING TREE TAGS, AND AN ATTENTION SIGN. THE NEW BT HAS A BRASS WASHER STAMPED PLS 346 NAILED TO THE LOWER BLAZE. THERE IS A FENCE POST ON LINE NEAR THE CORNER.

STEEL

Work Done By W.O. HARRIS Title \_\_\_\_\_ Date \_\_\_\_\_ State Registration No. or Agency PLS 346

Certified Cor. Record Prepared? Yes No Filed At: \_\_\_\_\_ Date \_\_\_\_\_

REMARKS


Index File No. T. R. M. Tract or Surv. No. Cor. 12 13

Index File No. L-1  
 T 6S R. 31E  
 Merid. Will.

CORNER RECORD (SEARCH)  
 (Ref. FSM 7151.4)  
 R.D. Ukiah County Umatilla  
 N.F. Umatilla State Oregon

Tract or Survey No. \_\_\_\_\_  
 Cor. No. L-1

CORNER DIAGRAM

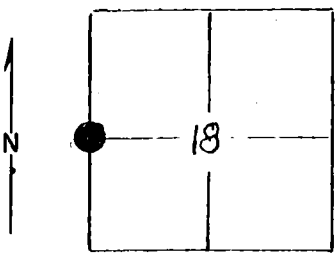

DESCRIBE CORNER MONUMENT FOUND

None  
*Monumented*

DESCRIBE BEARING TREES OR OTHER OFFICIAL ACCESSORIES FOUND

A 16" ponderosa pine in good vigor and condition bearing S22°E 49 lks has a good pair of scars indicating ¼S and bt markings. Painted a 6" band around it plus painted scars. Attached proper tags, put two steel posts up about 3' from approx. corner location and attached two metal signs to each, indicating a corner in property. There was already a bt tag on tree, put there by BLM.

PHOTO IDENTIFICATION DATA

Photo No. \_\_\_\_\_  
 Filed At. \_\_\_\_\_  
 Object Ident. \_\_\_\_\_  
 Ident. By \_\_\_\_\_  
*Signature*

DESCRIBE CORNER LOCATION RELATIVE TO NEAR-BY FEATURES, ALSO HOW TO REACH CORNER

PLANE COORDINATE POSITION DATA

State \_\_\_\_\_ Zone \_\_\_\_\_  
 X \_\_\_\_\_  
 Y \_\_\_\_\_  
 Estob. By \_\_\_\_\_  
*Agency*

Signature  
MLC

Title  
For Tech,

Division  
USFS

Headquarters  
Ukiah

Date  
4/20/78