

USDA-FOREST SERVICE

Index File No. P-07

CORNER RECORD (SEARCH)

(Ref. FSM 7151.4)

Tract or Survey No. _____ Cor. No. _____


T 6S R. 31E

R.D. NFJD County Umatilla

Merid. W.M.

N.F. Umatilla State Or.

CORNER DIAGRAM

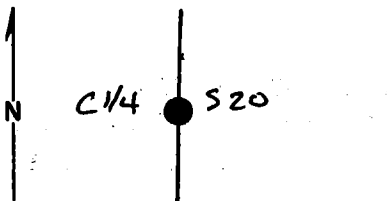

DESCRIBE CORNER MONUMENT FOUND

NONE

DESCRIBE BEARING TREES OR OTHER OFFICIAL ACCESSORIES FOUND

NONE

PHOTO IDENTIFICATION DATA

Photo No. _____
 Filed At. _____
 Object Ident. _____
 Ident. By _____

DESCRIBE CORNER LOCATION RELATIVE TO NEAR-BY FEATURES, ALSO HOW TO REACH CORNER

From jct of HWY 395 & Burma Rd. Travel westerly on Burma Rd. approx 2.8 miles to Rd. jct. Take road to left (westerly) approx 0.5 miles to a 4way jct. Go ~~west~~ west approx 0.2 miles. The corner is North approx 400 Feet.

PLANE COORDINATE POSITION DATA

State Or. Zone North
 X 242617198.046 meters
 Y 152862.632 meters
 Estab. By NAD 83 (1991)

Signature Dave Schmitt

Title Land Surveyor Division _____ Headquarters S.O. Date 7/94

CORNER RECORD (PERPETUATION)

MONUMENT: DESCRIBE NEW MONUMENT SET, OR WORK DONE TO PRESERVE EXISTING MONUMENT.

Set 2 1/2" by 30" aluminum pipe, with 3 1/4" aluminum cap, 6" in the ground and raised a mound of stone 4 feet in diameter by 2 feet high.

T6S R31E
C1/4
+
S20
PLS 1636
1994

ACCESSORIES: DESCRIBE NEW BT'S WITNESS OBJECTS ETC. ESTABLISHED, OR WORK DONE TO PRESERVE EXISTING EVIDENCE

16" Ponderosa Pine N25E 87.6 FT mkd "C V4 S20" "BT"
 20" Ponderosa Pine S84 1/2 E 176.2 FT. mkd "C V4 S20" "BT"
 18" Ponderosa Pine N26 1/2 W 81.2 FT. mkd "C V4 S20" "BT"
 RM, 5/8" x 2 1/4" Rebar with ~~3 1/4"~~ 1 1/2" aluminum cap,
 S27°17'W, 32.30 Feet mkd. "USDA-FS RM S20 C1/4 32 30 FT LS 1636"

Work Done By D. Gaylord Title Land Surveyor Date 9/94 State Registration No. PLS 1636
 or Agency

Certified Cor. Record Prepared? Yes No Filed At: Umatilla Co. Date

REMARKS

Index File No. P.07. T. 6S R. 31E M. W. M. Tract or Surv. No. Cor. 13