


# RECORD OF LAND CORNER MONUMENTATION

WEST QUARTER CORNER OF SECTION 6, T. 6 S., R. 32 E., W.M.

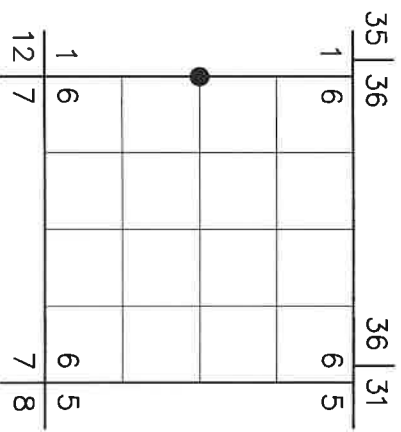

**ORIGINALLY ESTABLISHED BY:** Rufus S. Moore, U.S. Deputy Surveyor

**CONTRACT NUMBER:** 382

**CONTRACT DATE:** March 23, 1881

**SUBSEQUENT SURVEYS:**

- ▶ Dependent Resurvey, Subdivision of Sections, and Remonumentation of Township 6 South, Range 32 East, performed by James E. Jelley, Harvey E. Wofford, Craig L. Wanless, William D. Kimmel and Rick E. Tawney, Cadastral Surveyors, under Group Numbers 350 and 643 and approved on June 30, 1983.

**ORIGINAL DESCRIPTION:**

Set a basalt stone 16x10x4 in a mound of stone for ¼ sec. cor.

**SUBSEQUENT DESCRIPTION:**

The ¼ sec. cor. of secs. 1 and 6, monumented with a mound of stone, 4 ft. base, 2 ft. high, and is accepted as the best available evidence of the position of the original corner.

At the corner point

Set iron post, 28 ins. long, 2½ ins. diam., 14 ins. in the ground, to solid rock, in a mound of stone, 4 ft. base, to top, with brass cap mkd (diagram shown).

Corner is located in wire fence, extending N. and S.

**EVIDENCE FOUND:** Found 2 ½" iron pipe with 3 ¼" standard BLM brass cap in loose mound of stone, projecting 24" above ground with 5 ft. base. Corner is located 1 ft. west of wire fence, extending north and south.

**DESCRIPTION OF MONUMENTS AND ACCESSORIES SET AND METHODS USED:**

I accept the position of the found monument and rebuild the mound of stone, 5 ft. base, 20" tall.

**From which, I SET NEW REFERENCE MONUMENTS:**

- ▶ A ½" x 13" iron rod, bears N.54°E., 6.67 ft., with attached 2" aluminum cap marked RM 1 2024 PLS 91693.
- ▶ A ½" x 11" iron rod, bears S.44°E., 6.19 ft., with attached 2" aluminum cap marked RM 2 2024 PLS 91693.
- ▶ A ½" x 15" iron rod, bears S.49°W., 4.45 ft., with attached 2" aluminum cap marked RM 3 2024 PLS 91693.
- ▶ A ½" x 18" iron rod, bears N.44°W., 4.95 ft., with attached 2" aluminum cap marked RM 4 2024 PLS 91693.

FOUND CORNER MONUMENT:

Iron rods for reference monuments were driven into a drill hole in bedrock with the aluminum caps flush with the ground. Distances measured with steel tape. Bearings measured with a handheld compass with 14° East declination. Set an aluminum post 2.3 ft. north with USFS 54-2 & 54-9 signs attached.



**RESTORATION BY, STAMP AND DATE:**

Work performed June 6, 2024 by:

T. Delesus Quinones, LSIT



USDA FOREST SERVICE  
NORTHEAST OREGON LAND ZONE  
1550 Dewey Avenue, Suite A  
Baker City, OR 97814  
(541) 523-1281



24-079-R

RENEWS: 12/31/2024