

Index
 File No. U-15
 T 6S R. 32E
 Merid. W.M.


CORNER RECORD (SEARCH)

(Ref. FSM 7151.4)

R.D. N. Fk. J. Day County Umatilla
 N.F. Umatilla State Or.

Tract or
 Survey No. _____ Cor.
 No. _____

CORNER DIAGRAM

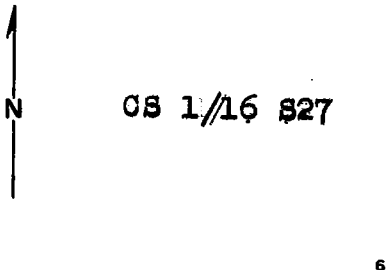

DESCRIBE CORNER MONUMENT FOUND

2 1/8" iron pipe with brass cap mkd.

CS 1/16
 |
 CS
 1968

DESCRIBE BEARING TREES OR OTHER OFFICIAL ACCESSORIES FOUND

P. Pine, 16", N67°W, 25.7', with healed blaze
P. Pine, 20", S45°E, 27.7', " " "

DESCRIBE CORNER LOCATION RELATIVE TO NEAR-BY FEATURES, ALSO HOW TO REACH CORNER

Corner falls on SW slope, north of 55 rd. and visible from rd. Posted line north & west.

PHOTO IDENTIFICATION DATA

Photo No. _____
 Filed At. _____
 Object Ident. _____
 Ident. By _____
Signature

PLANE COORDINATE POSITION DATA

State _____ Zone _____
 X _____
 Y _____
 Estab. By _____
Agency

Signature
F. J. Munro

Title
L.S.

Division

Headquarters

Date
11/19/86

CORNER RECORD (PERPETUATION)

MONUMENT: DESCRIBE NEW MONUMENT SET, OR WORK DONE TO PRESERVE EXISTING MONUMENT

None.

9

ACCESSORIES : DESCRIBE NEW BT'S WITNESS OBJECTS ETC. ESTABLISHED, OR WORK DONE TO PRESERVE EXISTING EVIDENCE

BTs have blaze and 6" band painted red, BT tags and "Land Survey Monument" signs. 6' steel fence post with "Land Survey Monument" sign within 5' of the corner..

10

Work Done By F.S. Munro Title L.S. Date 11/1/86 State Registration No. 1832
or Agency

Certified Cor. Record Prepared ? Yes No Filed At: Umatilla Co. Surveyor Date

11

REMARKS

12

Index File No. U-15 T. 6S R. 32E M. W.M. Tract or Surv. No. Cor.

13