

Index

File No. U-9

CORNER RECORD (SEARCH)

(Ref. FSM 7151.4)

Tract or Survey No. _____ Cor. No. _____


T 68 R. 32E

R.D. N. Fk. J. Day County Umatilla

Merid. W.M.

N.F. Umatilla State Or.

CORNER DIAGRAM

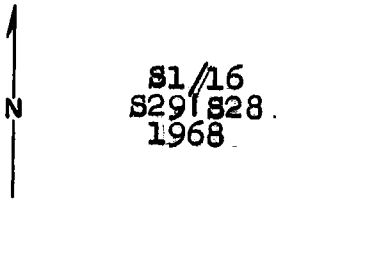

DESCRIBE CORNER MONUMENT FOUND 1

2 1/2" iron pipe with brass cap mkd. in stone mound. S1/16
S29/S28
1968

DESCRIBE BEARING TREES OR OTHER OFFICIAL ACCESSORIES FOUND 2

P. Pine, 14", N50W, 18.5', with healed blaze.
P. Pine, 9", N69OE, 42.5', " " " "

PHOTO IDENTIFICATION DATA 6

Photo No. _____
Filed At. _____
Object Ident. _____
Ident. By _____
Signature _____ 7

DESCRIBE CORNER LOCATION RELATIVE TO NEAR-BY FEATURES, ALSO HOW TO REACH CORNER 3

Corner falls on south slope. From K tag on 55 rd. follow posted line 804' north.

PLANE COORDINATE POSITION DATA

State _____ Zone _____
X _____
Y _____
Estab. By _____
Agency _____ 8

Signature
[Handwritten Signature]

Title L.S. Division _____ Headquarters _____ 4

Date 11/19/86 FS-7100-52 (3/68) 5

CORNER RECORD (PERPETUATION)

MONUMENT: DESCRIBE NEW MONUMENT SET, OR WORK DONE TO PRESERVE EXISTING MONUMENT

None..

ACCESSORIES : DESCRIBE NEW BT'S WITNESS OBJECTS ETC. ESTABLISHED, OR WORK DONE TO PRESERVE EXISTING EVIDENCE

BTs have blaze and 6" band painted red, BT tags and "Land Survey Monument" signs.. 6' steel fence post with "Land Survey Monument" sign within 5' of the corner.

Work Done By F.S. Munro Title L.S. Date 11/2/86 State Registration No. 1832
or Agency
Certified Cor. Record Prepared? Yes No Filed At: Umatilla Co. Surveyor Date

REMARKS

Index File No. U-9 T. 6S R. 32E M. W.M. Tract or Surv. No. Cor.