

Index
File No. W-6

CORNER RECORD (SEARCH)

(Ref. FSM 7151.4)

Tract or Survey No. _____ Cor. No. _____


T 6 S R. 32 E.

R.D. NORTH FORK JOHN DAY County UMATILLA

Merid. WILLAMETTE

N.F. UMATILLA State OREGON

CORNER DIAGRAM

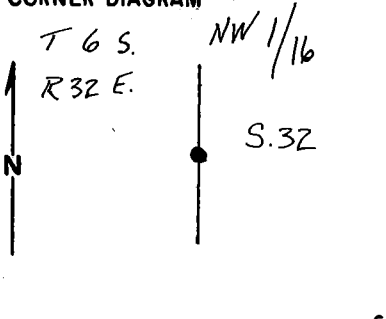

DESCRIBE CORNER MONUMENT FOUND

BLM BRASS CAP MKD. NW 1/16 S. 32 T6S R32E
SET ON 2 1/2" IRON POST IN MOUND OF STONE. 1968

DESCRIBE BEARING TREES OR OTHER OFFICIAL ACCESSORIES FOUND

A Fir, 12" DIAM., BEARS S 78° 11' W., 39.8 ft (RECORD S 77° W., 60 lks.)
A Fir, 12" DIAM., BEARS S 85° 47' E., 6.4 ft (RECORD S 85° E., 8 lks.)
BOTH TREES HAD HEALED BLAZES

PHOTO IDENTIFICATION DATA

Photo No. _____
Filed At. _____
Object Ident. _____
Ident. By _____
Signature _____

DESCRIBE CORNER LOCATION RELATIVE TO NEAR-BY FEATURES, ALSO HOW TO REACH CORNER

CORNER LOCATED ON 2ND BENCH SOUTH OF NORTH FORK JOHN DAY RIVER. FROM LOGGING ROAD AT NE 1/4 SEC. 32 FOLLOW RD WESTERLY APPROX. 9/10 MILE TO WHERE ROAD BEARS SOUTH. 300 FT WEST OF CURVE IS POSTED SUBDIVISIONAL LINE BETWEEN NW 1/16 AND CW 1/16 CORNERS. FOLLOW POSTED LINE 400' NORTH, DESCENDING TO CORNER ON FLAT.

PLANE COORDINATE POSITION DATA

State _____ Zone _____
X _____
Y _____
Estab. By _____
Agency _____

Signature Ken Bibe Title Aty Chief Division _____ Headquarters _____ Date 10/90 FS-7100-52 (3/68)

CORNER RECORD (PERPETUATION)

MONUMENT: DESCRIBE NEW MONUMENT SET, OR WORK DONE TO PRESERVE EXISTING MONUMENT

CLEARED BRUSH AND DEBRIS FROM AROUND BRASS CAP

ACCESSORIES : DESCRIBE NEW BT'S WITNESS OBJECTS ETC. ESTABLISHED, OR WORK DONE TO PRESERVE EXISTING EVIDENCE

ESTABLISHED NEW BT. A 12" FIR, BEARS N 15° 22' E., 19.5 FT., SCRIBED NW 1/4 S. 32 BT, WITH BRASS WASHER #1341 NAILED TO BLAZE BETWEEN BT'S.

ATTACHED USFS 54-3 SIGN TO NEW BT AND 54-9 TO ALL BT'S. PAINTED RED BAND AROUND ALL TREES. SET GUARD POST 5 FT EAST OF CORNER WITH 54-2 AND 54-9 SIGNS ATTACHED.

Work Done By: GUY (PAT) STREWLER Title: LAND SURVEYOR Date: 10/90 State Registration No. or Agency: 1341-
 Certified Cor. Record Prepared? (Yes) NO Filed At: UMATILLA COUNTY SURVEYOR Date:

REMARKS

Ken BATES
 WITNESS: SCOTT KRIKA

Index File No. W-6 T. 6S R. 32E M. WM Tract or Surv. No. Cor.