

USDA-FOREST SERVICE

Index  
File No. W-7

CORNER RECORD (SEARCH)

(Ref. FSM 7151.4)

Tract or  
Survey No. \_\_\_\_\_ Cor.  
No. \_\_\_\_\_


T 6 S. R. 32E-

R.D. NORTH FORK JOHN DAY County UMATILLA

Merid. WILLAMETTE

N.F. UMATILLA State OREGON

CORNER DIAGRAM

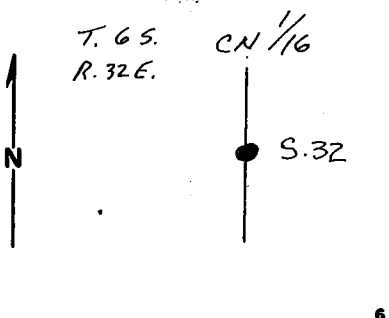

DESCRIBE CORNER MONUMENT FOUND

BLM BRASS CAP MKD. 765 c 1232E  
N 1/16 | S. 32  
Set on 2 1/2" IRON POST IN c  
GROUND OF STONE. 1968

DESCRIBE BEARING TREES OR OTHER OFFICIAL ACCESSORIES FOUND

A 12" FIR, BEARS S 85° 45' E., 58.1' dist, HEALED BLAZE (RECORD S 87 1/2° E, 871K3)  
A 10" FIR, BEARS S 57° W., 3.3' dist, HEALED BLAZE (RECORD S 56° W, 51K5)

PHOTO IDENTIFICATION DATA

Photo No. \_\_\_\_\_  
Filed At. \_\_\_\_\_  
Object Ident. \_\_\_\_\_  
Ident. By \_\_\_\_\_  
*Signature*

DESCRIBE CORNER LOCATION RELATIVE TO NEAR-BY FEATURES, ALSO HOW TO REACH CORNER

CORNER LOCATED ON A MEDIUM TIMBERED FLAT. CORNER SITS 40 FT. SOUTH OF LOGGING ROAD RUNNING WEST BY SOUTHWEST THROUGH THE NORTH 1/2 OF THE NE 1/4 S. 32. A 4"x4" WOOD POST WITH LOCATION POSTER ATTACHED FOUND ON SOUTH SIDE OF ROAD APPROX 40 FT NORTH OF CORNER.

PLANE COORDINATE POSITION DATA

State \_\_\_\_\_ Zone \_\_\_\_\_  
X \_\_\_\_\_  
Y \_\_\_\_\_  
Estab. By \_\_\_\_\_  
*Agency*

Signature

*Ken B. B...*

Title

*PTA Chief*

Division

Headquarters

Date

*10/190*

FS-7100-52 (3/68)

CORNER RECORD (PERPETUATION)

MONUMENT: DESCRIBE NEW MONUMENT SET, OR WORK DONE TO PRESERVE EXISTING MONUMENT

REMOVED BRUSH AND DEBRIS FROM AROUND BRASS CAP. RESET MOUND OF STONE.

ACCESSORIES : DESCRIBE NEW BT'S WITNESS OBJECTS ETC. ESTABLISHED, OR WORK DONE TO PRESERVE EXISTING EVIDENCE

NEW BEARING TREE: A 10" FIR, BEARS N 3° E, 42.4 FT., SCRIBED CN 1/16 S. 32, BT. A BRASS WASHER #1341 NAILED BETWEEN B AND T ON BLAZE. 54-3 AND 54-9 USFS SIGNS ATTACHED AND 6" RED BAND PAINTED AROUND TREE

ATTACHED 54-9 SIGNS TO ALL BT'S AND PAINTED 6" RED BAND AROUND ALL BT'S.

SET GUARD POST WITH 54-2 AND 54-9 SIGNS ATTACHED 5 FT. WEST OF CORNER.

Work Done By Guy (PAT) STEWART Title LAND SURVEYOR Date 10/90 State Registration No. 1341 or Agency

Certified Cor. Record Prepared?  YES  NO Filed At: UMATILLA COUNTY SURVEYOR Date 2/91

REMARKS

WITNESS: KEN BATES  
SCOTT KRUKA

Index File No. W-7 T. 6S R. 32E M. WM Tract or Surv. No. Cor.