

USDA-FOREST SERVICE

Index
File No. X-8

CORNER RECORD (SEARCH)

Tract or
Survey No. _____ Cor.
No. _____


T 6 S R. 32 E

R.D. NORTH FORK JOHN DAY County UMATILLA

Merid. WILLAMETTE

N.F. UMATILLA State OREGON

CORNER DIAGRAM

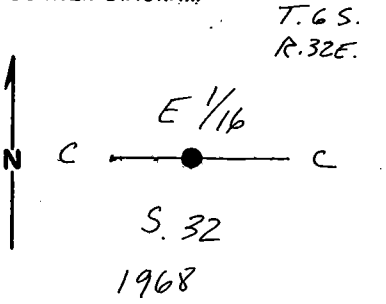

DESCRIBE CORNER MONUMENT FOUND

BLM BRASS CAP MKD. ^{T.G.S.} E 1/16 ^{R.32E}
S 32
SET ON 2 1/2" IRON POST 1968
IN MOUND OF STONE

DESCRIBE BEARING TREES OR OTHER OFFICIAL ACCESSORIES FOUND

A fir, 9" DIAM., BEARING N 68° 40' E., 3.9 ft. (RECORD N 66° E., 11 lks)
WITH HEALED BLAZE. (BT replaced because this tree is dying)

A fir, 18" DIAM., BEARING S 21° 39' W., 57² ft. (RECORD S 22° W., 86 1/2 lks)
WITH HEALED BLAZE.

PHOTO IDENTIFICATION DATA

Photo No. _____
Filed At. _____
Object Ident. _____
Ident. By _____
Signature

PLANE COORDINATE POSITION DATA

State _____ Zone _____
X _____
Y _____
Estab. By _____
Agency

DESCRIBE CORNER LOCATION RELATIVE TO NEAR-BY FEATURES, ALSO HOW TO REACH CORNER

CORNER located 200' south of stream at base of SW FACING HILLSIDE.
Follow logging road through NE 1/4 sec. 32 to Forest Service location posted
ON 4" x 4" WOOD POST, SOUTH SIDE OF ROAD, 49 ft N. of CN 1/16 COR. Follow
POSTED SUBDIVISIONAL LINE SOUTH 1300 ft. to CE 1/16 CORNER POINT.

Signature _____ Title _____ Division _____ Headquarters _____ Date _____

K. B. B. B.

Plt Chief

10/90

CORNER RECORD (PERPETUATION)

MONUMENT: DESCRIBE NEW MONUMENT SET, OR WORK DONE TO PRESERVE EXISTING MONUMENT

CLEARED AWAY BUSH AND DEBRIS FROM CORNER

9

ACCESSORIES : DESCRIBE NEW BT'S WITNESS OBJECTS ETC. ESTABLISHED, OR WORK DONE TO PRESERVE EXISTING EVIDENCE

NEW BT: a fir, 4' diam BEARS N 78° 28' W., 11.6 FT., MKD. CE 1/16" with USFS 54-3 AND 54-9 SIGNS ATTACHED AND A 6" RED BAND PAINTED AROUND TREE. TO REPLACE DYING TREE

S. 32
BT

ATTACHED USFS 54-9 SIGNS TO ALL BT'S
PAINTED RED BANDS AROUND ALL BT'S

SET GUARD POST WITH 54-2 AND 54-9 SIGNS ATTACHED 5 FT. SOUTH OF CORNER

10

Work Done By: Guy Streamer Title LAND SURVEYOR Date 10/90 State Registration No. or Agency 1341 - STREAMER

Certified Cor. Record Prepared? Yes No Filed At: UMATILLA COUNTY SURVEYOR Date 2/91

11

REMARKS

WITNESSES: KEN BATES
SCOTT KRICKA

12

Index File No. X-8 T. 6S R. 32E M. WM Tract or Surv. No. Cor. 13