

Index File No. Y-6

CORNER RECORD (SEARCH)

(Ref. FSM 7151.4)

Tract or Survey No. _____

Cor. No. _____


T 6 S. R. 32 E.

R.D. NORTH FORK JOHN DAY County UMATILLA

Merid. WILLAMETTE

N.F. UMATILLA State OREGON

CORNER DIAGRAM

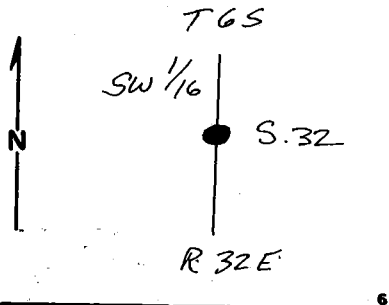

DESCRIBE CORNER MONUMENT FOUND

BLM BRASS CAP MED. SW $\frac{1}{16}$ S. 32 SET ON $2\frac{1}{2}$ " IRON POST IN STONE MOUND
1968

DESCRIBE BEARING TREES OR OTHER OFFICIAL ACCESSORIES FOUND

A PINE, 34" DIAM., BEARS $N 46^{\circ} 37' W$, 152.5 FT. (RECORD $N 49^{\circ} W$, ^{155.76 FT} 236 LKS.)
FACE HEALED AND DID NOT OPEN.

A PINE, 20" DIAM., BEARS $N 13^{\circ} 12' E$, 171.9 FT. (RECORD $N 12^{\circ} 30' E$, ^{172.26 FT} 261 LKS.)
FACE HEALED AND DID NOT OPEN.

DESCRIBE CORNER LOCATION RELATIVE TO NEAR-BY FEATURES, ALSO HOW TO REACH CORNER

CORNER IS APPROX. 500 FT. SWLY OF RIDGE TOP LOCATED IN SW $\frac{1}{4}$ OF NE $\frac{1}{4}$ OF SW $\frac{1}{4}$ OF S. 32.

FOLLOW MAIN LOGGING TRAIL FOR NE COR. S. 32 WEST BY SOUTHWEST APPROX. ONE MILE TO A POINT 200 FT. EAST OF CS $\frac{1}{16}$ COR S. 32. FOLLOW POSTED INTERIOR LINE WEST TO SW $\frac{1}{16}$ COR.

PHOTO IDENTIFICATION DATA

Photo No. _____
Filed At. _____
Object Ident. _____
Ident. By _____
Signature _____

PLANE COORDINATE POSITION DATA

State _____ Zone _____
X _____
Y _____
Estab. By _____
Agency _____

Signature Kenn Betton

Title Dist Chief

Division _____

Headquarters _____

Date _____

FS-7100-52 (3/68)

10/90

CORNER RECORD (PERPETUATION)

MONUMENT: DESCRIBE NEW MONUMENT SET, OR WORK DONE TO PRESERVE EXISTING MONUMENT

REMOVED BRUSH AND DEBRIS FROM AROUND BRASS CAP. RESET PILE OF STONE.

ACCESSORIES : DESCRIBE NEW BT'S WITNESS OBJECTS ETC. ESTABLISHED, OR WORK DONE TO PRESERVE EXISTING EVIDENCE

ON 34" DIAM. PINE REPLACED BEARING TREE SIGN WITH NEW 54-3 SIGN WITH NEW BEARING AND DISTANCE.
PLACED MONUMENT SIGNS, 54-9, AND PAINTED RED BAND AROUND BOTH BT'S
DROVE GUARD POST 5 FT SOUTH OF BRASS CAP WITH 54-9 MONUMENT SIGN ATTACHED.

Work Done By Guy Streamer Title LAND SURVEYOR Date 10/90 State Registration No. or Agency 1341-STREAMER
Certified Cor. Record Prepared? Yes No Filed At: UMATILLA COUNTY SURVEYOR Date 2/91

REMARKS

WITNESS: Ken Bates
Scott Kenica

Index File No. Y-6 T. 6S R. 32E M. WM Tract or Surv. No. Cor.