

Index File No. 2-17

CORNER RECORD (SEARCH)

Tract or Survey No. _____

LL 63
Cor. No. 2-17

T 6S R. 32E


R.D. DALE County UMATILLA

Merid. Will

N.F. UMATILLA State OREGON

CORNER DIAGRAM

dw/1/84

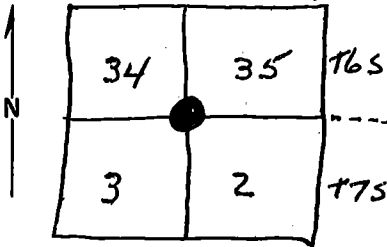

DESCRIBE CORNER MONUMENT FOUND

*Bress cap:
see mon. file*

*T 6 S R 32 E
534 | 535
5 3 | 5 2
T 7 S
1967*

DESCRIBE BEARING TREES OR OTHER OFFICIAL ACCESSORIES FOUND

PHOTO IDENTIFICATION DATA

Photo No. _____
Filed At. _____
Object Ident. _____
Ident. By _____
Signature

DESCRIBE CORNER LOCATION RELATIVE TO NEAR-BY FEATURES, ALSO HOW TO REACH CORNER

PLANE COORDINATE POSITION DATA

State _____ Zone _____
X _____
Y _____
Estab. By _____
Agency

Signature

Salisbury

Title

Division

Headquarters

S.O.

Date

12-20-67

7100-52

REV. 65 5

CORNER RECORD (PERPETUATION)

MONUMENT: DESCRIBE NEW MONUMENT SET, OR WORK DONE TO PRESERVE EXISTING MONUMENT

Brass Cap Set 1967

ACCESSORIES : DESCRIBE NEW BT'S WITNESS OBJECTS ETC. ESTABLISHED, OR WORK DONE TO PRESERVE EXISTING EVIDENCE

Work Done By BLM Title _____ Date _____ State Registration No. or Agency _____

Certified Cor. Record Prepared ? Yes No Filed At: _____ Date _____


REMARKS

Index File No. Z-17 T. R. M. Tract or Surv. No. Cor. _____

LAND CORNER RECORD

1. T. 6S R. 32E No. 2-17 Cor. SE Mer. W.M. State Oregon (Rectangular) N. F. Umlauf Dist. Dale

2. Corner Status

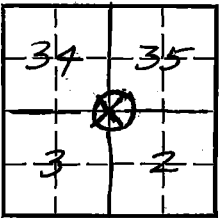

7. Photo Identification

Photo No. _____

Ident. By: _____

8. Plane Coordinate Position Data

State _____ Zone _____

X _____

Y _____

Estab. By _____

Field Book No. _____

Where Filed _____

9. Evaluation

Authentic _____

Needs Verif. _____ Monument NO

Re-estab. Survey _____

Land Status _____

3. Original Description _____ Vol. _____ Page _____ Where Recorded _____

4. Description of Corners: *Originally a fir post which is now gone. Of the four BT's only two remain. One is a mistletoed Douglas-fir and the other a 4" Larch snag with the scribbing opened up.*

5. Investigation Notes: *I walked down the trail on the east side of Trough Cr. past the first saddle and almost to the second saddle near Spine Cob Knob. I found a pine blazed with an 'X' on the east edge of the trail. Near there was a small tree blazed with and with writing which told to go 5 1/2 chains east to the corner. I followed plastic flagging to the corner. The fir 27 lks from the corner is standing and alive with a 1937 cruiser's tag on it the 4" Larch is standing but dead. The scribbing was chopped out. I put a BT shield sign on it and painted an aluminum BT in both trees.*

6. Signed John M. Dolan Title T.M.A. Date 6-12-62

PERPETUATION RECORD

10. Monument:

11. Accessories

Field Book _____ Page _____

12. Set By _____ Title _____

13. Recorded By _____ Volume _____ Page _____

(Agency)

License _____ Agency _____ Date _____

(Date) _____ (City) _____ (County) _____ (State) _____

14. Remarks:

T65, R32E, Z-17 - Sec. 34+35