


USDA-FOREST SERVICE

Index
File No. 2-8
T 65 R. 32 E
Merid. WILLAMETTE

CORNER RECORD (SEARCH)

(Ref. FSM 7151.4)
R.D. North Fork JOHN DAY County UMATILLA
N.F. UMATILLA State OR
Tract or Survey No. _____ Cor. No. _____

CORNER DIAGRAM

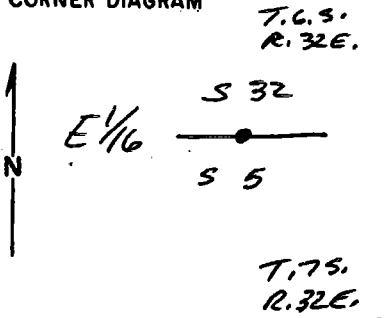

DESCRIBE CORNER MONUMENT FOUND

BRASS CAP MCD. E 1/16 S 32 SET ON IRON POST
S 5 IN MOUND OF STONE
1968

DESCRIBE BEARING TREES OR OTHER OFFICIAL ACCESSORIES FOUND

BT, a FIR 20" DIAM., BEARS N. 46 1/2° W., 74 lks, HEALED BLAZE
USFS SIGNS 54-3 AND 54-9

BT, a PINE 11" DIAM., BEARS S 45 1/2° W., 48 1/2 lks, HEALED BLAZE
USFS SIGNS 54-3 AND 54-9

2 GUARD POSTS, E. AND W. OF CORNER MONUMENT,

PHOTO IDENTIFICATION DATA

Photo No. _____

Filed At. _____

Object Ident. _____

Ident. By _____
Signature

DESCRIBE CORNER LOCATION RELATIVE TO NEAR-BY FEATURES, ALSO HOW TO REACH CORNER

CROSS N. FORK JOHN DAY RIVER IN SW OF SECTION 28 T. 6 S., R. 32 E.,
FOLLOW LOGGING ROAD W. N. W. APPROX. ONE MILE. ROAD TURNS EAST, 90
APPROX. 1000' TO USFS LOCATION POSTER ATTACHED TO 4" X 4" WOOD POST
SET ON SOUTH SIDE OF LOGGING ROAD. FOLLOW POSTER SUB-DIVISIONAL
LINE APPROX. 600' TO CORNER MONUMENT.

PLANE COORDINATE POSITION DATA

State _____ Zone _____

X _____

Y _____

Estab. By _____
Agency

Signature [Signature] Title Dist Chief Division _____ Headquarters _____ Date 12/90

CORNER RECORD (PERPETUATION)

MONUMENT : DESCRIBE NEW MONUMENT SET, OR WORK DONE TO PRESERVE EXISTING MONUMENT

CLEARED BRUSH FROM AROUND CORNER MONUMENT

9

ACCESSORIES : DESCRIBE NEW BT'S WITNESS OBJECTS ETC. ESTABLISHED, OR WORK DONE TO PRESERVE EXISTING EVIDENCE

PAINTED BT'S

10

Work Done By GUY (PAT) STAMMER Title LAND SURVEYOR Date 12/70 State Registration No. PLS 1341
or Agency

Certified Cor. Record Prepared ? Yes No Filed At: _____ Date _____ 11

REMARKS

WITNESS: KEN BATES

12

Index File No. Z-8 T. 6S R. 32E M. WM Tract or Surv. No. _____ Cor. _____ 13