

OREGON CORNER RESTORATION FORM

Section 5 Township 6S Range 33E
 County Umatilla Date: August 24, 2005

Corner Designation: 6S33C5

Condition Report Only

1/4 corner to sections 5 and 6, T6S, R33E W.M.
 Umatilla County, Oregon.

Not found
 Remonumented
 Unrecorded
 Surveyed in
 Referenced out

Previous Renewals / Surveys, etc.


Corner originally set by Frank W. Campbell under contract No. 468 dated April 12, 1883. His record reads: Set fir post, 3 ft. long, 3 ins. sq., 24 ins. in ground, for 1/4 sec. cor., marked 1/4S on V face, from which: A fir, 18 ins. diam., brs. S.48°E., 8 lks. dist., marked 1/4 S B T; A fir, 18 ins. diam. brs. N.78°W., 6 lks. dist., marked 1/4 S B T.

Monument and Accessories found: (condition and source)

An orange steel post with a BLM location poster stating the corner is "here". Communication with the BLM office indicates that this post was set by administrative survey and is not considered to be the actual corner point. No other evidence was found.

DIAGRAM

SKETCH

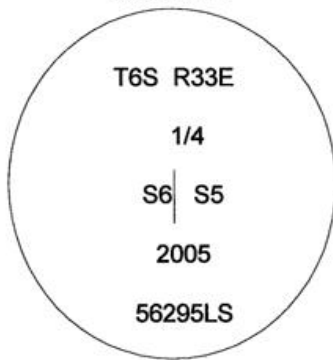

MONUMENT (S) AND ACCESSORIES SET (Procedures and Description)

Set a 1 1/4" x 30" Galvanized Iron Pipe with a 2 1/2" brass cap stamped as shown in the diagram above at the proportionate point.

For references, I set four 5/8" by 24" rebars with 1.25" orange plastic caps stamped WTS and 56295LS as described below:

- an iron rebar bears N35°04'13"E, 31.50 feet;
- an iron rebar bears N18°08'02"W, 29.57 feet;
- an iron rebar bears N86°43'57"W, 34.06 feet;
- an iron rebar bears S13°19'30"E, 27.22 feet;

This monument and references were set and tied using a Trimble R7/R8 RTK GPS.

Location and comments

Compass Declination

Surveyors Seal

RECEIVED BY:
Umatilla County Surveyor
 Date: 10-05
 Rec'd By: KK
 No. 05-176-B

Firm / Agency
 Witness Tree Surveying
 Address
 P.O. Box G
 Pilot Rock, Or. 97868
 Party Chief
 Stephen K, Haddock

