

USDA-FOREST SERVICE

Index

File No. J-5

T 6S R. 33E

Merid. Williamette

CORNER RECORD (SEARCH)

(Ref. FSM 7151.4)


R.D. Ukiah County _____

N.F. Umatilla State _____

Tract or Survey No. _____

Cor. No. J-5

CORNER DIAGRAM

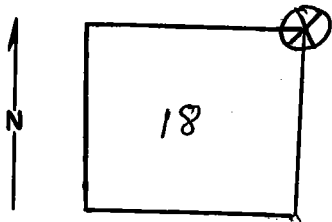

DESCRIBE CORNER MONUMENT FOUND

None

DESCRIBE BEARING TREES OR OTHER OFFICIAL ACCESSORIES FOUND

28" Fir - SW Quad. - Closed NE blaze & BT's. Attention posters on it.

12" Fir - SE Quad. - Closed NE blaze & posters on it.

PHOTO IDENTIFICATION DATA

Photo No. _____

Filed At. _____

Object Ident. _____

Ident. By _____

Signature

PLANE COORDINATE POSITION DATA

State _____ Zone _____

X _____

Y _____

Estab. By _____

Agency

DESCRIBE CORNER LOCATION RELATIVE TO NEAR-BY FEATURES, ALSO HOW TO REACH CORNER

~~Check existing file.~~

Signature

B. Moore

Title

Division

Headquarters

Date

10/79

7100-52-(3/68)

CORNER RECORD (PERPETUATION)

MONUMENT: DESCRIBE NEW MONUMENT SET, OR WORK DONE TO PRESERVE EXISTING MONUMENT

ACCESSORIES : DESCRIBE NEW BT'S WITNESS OBJECTS ETC. ESTABLISHED, OR WORK DONE TO PRESERVE EXISTING EVIDENCE

Work Done By _____ Title _____ Date _____ State Registration No. _____
or Agency _____

Certified Cor. Record Prepared ? Yes No Filed At: _____ Date _____

REMARKS


Index File No. _____ T. _____ R. _____ M. _____ Tract or Surv. No. _____ Cor. _____
U.S. G.P.O. 1977-725-576/586

LAND CORNER RECORD

5680-2

1. T 65 R 33E No. J5 Cor. Sec Mer. Will. State Oregon (Rectangular) N. F. Umatilla Dist. Ukiah

2. Corner Status

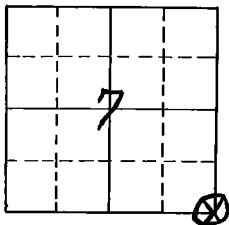

3. Original Description Vol. _____ Page _____ Where Recorded Ukiah R.D.

4. Description of Corners: Basalt stone 15" x 15" x 12" 10" in ground
A Pine 4" dia. br N. 14° E. 21 LKS.
A Fir 8" dia. br S. 10° E. 21 LKS.
A Fir 20" dia. br S. 31° W. 24 LKS.
A Tamarack 4" dia. br N. 42° W. 42 LKS.
(WKS)

5. Investigation Notes:

Douglas Fir 12" dia., Fair Vigor, scribing found
Douglas Fir 24" dia., good Vigor, Face visible
painted trees with Red Stripes
placed forms 54-3 and 54-4

7. Photo Identification

Photo No. _____

Ident. By: _____

8. Plane Coordinate Position Data

State _____ Zone _____

X _____

Y _____

Estab. By _____

Field Book No. _____

Where Filed _____

9. Evaluation

Authentic _____

Needs Verif. _____ Monument _____

Re-estab. _____ Survey _____

Land Status _____

6. Signed Kenneth Johnson Title Forester Date 5-6-66

PERPETUATION RECORD

10. Monument :

11. Accessories

Field Book _____ Page _____

12. Set By _____ Title _____

License _____ Agency _____ Date _____

13. Recorded By _____ (Agency) _____ Volume _____ Page _____

(Date) (City) (County) (State)

14. Remarks:

J-5