


History of original corner establishment:

The original corner was established by Frank W. Campbell on July 4, 1883, under GLO contract No. 468, as follows:

- Set a post for the corner from which:
- A 10" pine bears S30°W, 10 links (6.6 feet).
- A 5" pine bears N65°E, 20 links (13.2 feet).

On July 14, 1987, Duane I. Griffith, PLS 644, was unable to find evidence of the original corner. Griffith reestablished the corner by proportionate measurement, and set the following:

- A 2 1/2" aluminum pipe with an aluminum cap attached, marked as shown in the diagram above, from which:
- A 15" Douglas-fir bears N56°E, 98.21 feet.
- A 8" Western Larch bears N2°W, 54.79 feet.

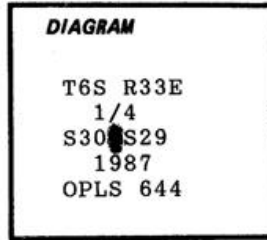

Description of corner evidence found:


- A 2 1/2" aluminum pipe protruding 2" above the ground with a 2 1/2" aluminum cap attached which is marked as shown in the diagram above, from which:
- A down and dead Douglas-fir with healed blazes. Root hole bears N59°E, 98.5 feet.
- A 8" Western Larch snag with double healed blazes bears N1°W, 54.9 feet.

Description of monument and accessories established to perpetuate the original location of this corner:

New references:

- A 29" Douglas-fir, scribed "1/4 S29 BT" on double blazes, bears N11°E, 137.0 feet. This tree has a 3/4" brass washer, marked "PLS 1636", nailed flush to the lower blaze, a 54-3, "Bearing Tree", sign nailed above the blazes and a 54-4, "Attention", sign nailed to the back.
- A 5/8" x 36" iron rod, set 35" into the ground with a 3/4" brass washer, marked "PLS 1636 S29", attached at ground level, bears S62°30'E, 96.7 feet.
- A 5/8" x 36" iron rod, set 35" into the ground with a 3/4" brass washer, marked "PLS 1636 S30 SW", attached at ground level, bears S46°15'W, 58.6 feet.
- A 5/8" x 36" iron rod, set 35" into the ground with a 3/4" brass washer, marked "PLS 1636 S30 NW", attached at ground level, bears N37°15'W, 117.7 feet.

I hereby certify the above corner point was perpetuated as hereon described on April 10, 1997. Magnetic declination: 20°E.

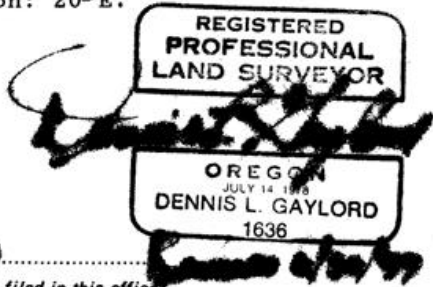

Office of _____ County of _____
 State of _____, I hereby certify that the within instrument was filed in this office
 for record on the _____ day of _____, 19____
 _____ by _____
 (COUNTY OFFICIAL) (DEPUTY)

Form R6-7100-57 (9/71)

RECEIVED BY
 Umatilla County Surveyor
 Date 4-97
 Rec'd By KR
 No. 97-74-R