

USDA-FOREST SERVICE

Index
File No. X-3

CORNER RECORD (SEARCH)

(Ref. FSM 7151.4)

Tract or
Survey No. X-3


T 6S R. 33E

R.D. Ukiah County Umatilla

Merid. Willamette

N.F. Umatilla State Oregon

CORNER DIAGRAM

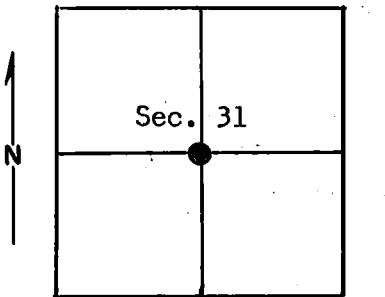

DESCRIBE CORNER MONUMENT FOUND

None

DESCRIBE BEARING TREES OR OTHER OFFICIAL ACCESSORIES FOUND

None

PHOTO IDENTIFICATION DATA

Photo No. _____
Filed At. _____
Object Ident. _____
Ident. By _____
Signature

DESCRIBE CORNER LOCATION RELATIVE TO NEAR-BY FEATURES, ALSO HOW TO REACH CORNER

From Texas Bar, take Nye Creek Road S678. Go $3\frac{1}{4}$ miles, turn left on jeep trail. Go $\frac{1}{2}$ mile and corner is North about 15 chns. from road.

PLANE COORDINATE POSITION DATA

State _____ Zone _____
X _____
Y _____
Estab. By _____
Agency

Signature

Beth Ann Murphy

Title

Party Chief

Division

Headquarters

Krumbein Engineering

Date

14 Sep 78

7100-52-(3/68)

CORNER RECORD (PERPETUATION)

MONUMENT: DESCRIBE NEW MONUMENT SET, OR WORK DONE TO PRESERVE EXISTING MONUMENT

T 6S R 33E

Set 2 1/2" x 30" iron pipe with brass cap (stamped)

C 1/4 S 31

Pipe is 24 in. in ground.

1978
PLS 933

9

ACCESSORIES : DESCRIBE NEW BT's WITNESS OBJECTS ETC. ESTABLISHED, OR WORK DONE TO PRESERVE EXISTING EVIDENCE

Scribed BV

Tamarack 16 in. diam. brs. N 05° E 9.00 ft. marked C 1/4 S31 BT with signs 54-3 and 54-4 and brass washer. Tamarack 19 in. diam. brs. S 89° E 32.50 ft. marked C 1/4 S31 BT with signs 54-3 and 54-4 and brass washer.

Set steel post 4 ft. South of corner with sign 54-4.

Painted scribed area and red band around trees.

10

Work Done By P. Murphy Title Party Chief Date 8/31/78 State Registration No. or Agency _____

Certified Cor. Record Prepared ? Yes No _____ Filed At: County Surveyor Date _____ 11

REMARKS

Witness by: R. Barton
M. Murtishaw

Index File No. X-3 T. 6S R. 33E M. Willamette Tract or Surv. No. Cor. 12 13