


History of original corner establishment:

Unsurveyed - subdivided section.

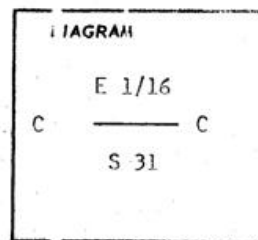

No record of subsequent remonumentation found in County Records.

Description of corner evidence found:


None.

Description of monument and accessories established to perpetuate the original location of this corner

Set 2 1/2" x 30" iron pipe 25" in ground with brass cap marked as shown from which I scribed bearing trees:

- A pine 14in. diam. brs. N 07°07' W 24.60 ft. marked C E1/16 S31 BT
- A pine 14 in. diam. brs. S 40°45' E 56.10 ft. marked C E1/16 S31 BT

Mailed a brass washer marked PLS 933 to the BT blaze of bearing trees. Set a steel post 4 ft. South of corner. Used a T-2 and steel tape, measuring a horizontal distance to the center of bearing trees.

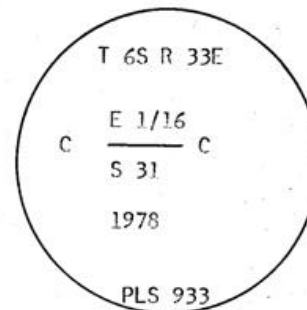

Office of County Surveyor County of Umatilla
 State of Oregon, I hereby certify that the within instrument was filed in this office for record on the day of
 _____ by _____
 (COUNTY OFFICIAL) (DEPUTY)