

USDA-FOREST SERVICE

Index
File No. Y-3

CORNER RECORD (SEARCH)


(Ref. FSM 7151.4)

Tract or
Survey No. _____ No. Y-3

T 6S R. 33E R.D. Ukiah County Umatilla

Merid. Willamette N.F. Umatilla State Oregon

CORNER DIAGRAM

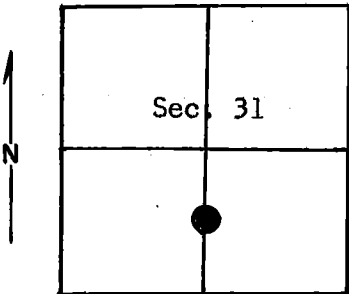

DESCRIBE CORNER MONUMENT FOUND

None

DESCRIBE BEARING TREES OR OTHER OFFICIAL ACCESSORIES FOUND

None

PHOTO IDENTIFICATION DATA

Photo No. _____

Filed At. _____

Object Ident. _____

Ident. By _____

Signature

PLANE COORDINATE POSITION DATA

State _____ Zone _____

X _____

Y _____

Estab. By _____

Agency

DESCRIBE CORNER LOCATION RELATIVE TO NEAR-BY FEATURES, ALSO HOW TO REACH CORNER

From Texas Bar, take Nye Creek Road No. S678. Go $3\frac{1}{4}$ miles turn left on jeep trail. Go $\frac{1}{2}$ mile. Corner is 12 ft. West of road.

Signature

Party Chief

Title

Division

Headquarters

Krumbein Engineering

Date

14 Sep 78

7100-52-(3/68)

CORNER RECORD (PERPETUATION)

MONUMENT: DESCRIBE NEW MONUMENT SET, OR WORK DONE TO PRESERVE EXISTING MONUMENT

T 6S R 33E

Set 2½" x 30" iron pipe with brass cap (stamped)

S 1/16 | S 31

Pipe is 25" in ground.

C
C
1978
PLS 933

9

ACCESSORIES: DESCRIBE NEW BT'S WITNESS OBJECTS ETC. ESTABLISHED, OR WORK DONE TO PRESERVE EXISTING EVIDENCE

Scribed BTs

Fir 11 in. diam. brs. N 08° 56' W 10.10 ft. marked S 1/16 C S31 BT with signs 54-3, and 54-4, and brass washer. Tamarack 16" diam. brs. N 87° 38' W 61.5 ft. marked S 1/16 C S31 BT with signs 54-3 and 54-4, and brass washer.
Set steel post 3 ft. East signs 54-2 and 54-3.
Painted scribed area and red band around trees.

10

Work Done By: P. Murphy Title Party Chief Date 8/28/78 State Registration No. _____
or Agency _____Certified Cor. Record Prepared? Yes No _____ Filed At: County Surveyor Date _____ 11

REMARKS

Witness by: R. Barton
M. MurtishawIndex File No. Y-3 T. 6S R. 33E. M. Willamette Tract or Surv. No. _____ Cor. _____ 12
13