

USDA-FOREST SERVICE

Index

File No. Y-4

**CORNER RECORD (SEARCH)**

(Ref. FSM 7151.4)

Tract or Survey No. \_\_\_\_\_ No. Y-4


T 6S R. 33E

R.D. Ukiah County Umatilla

Merid. Willamette

N.F. Umatilla State Oregon

**CORNER DIAGRAM**

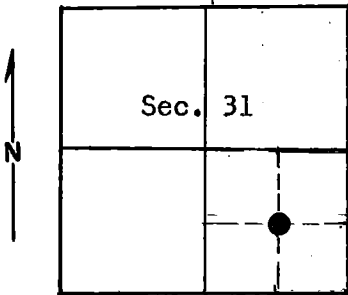

**DESCRIBE CORNER MONUMENT FOUND**

None

**DESCRIBE BEARING TREES OR OTHER OFFICIAL ACCESSORIES FOUND**

None

**PHOTO IDENTIFICATION DATA**

Photo No. \_\_\_\_\_

Filed At. \_\_\_\_\_

Object Ident. \_\_\_\_\_

Ident. By \_\_\_\_\_

*Signature*

**PLANE COORDINATE POSITION DATA**

State \_\_\_\_\_ Zone \_\_\_\_\_

X \_\_\_\_\_

Y \_\_\_\_\_

Estab. By \_\_\_\_\_

*Agency*

**DESCRIBE CORNER LOCATION RELATIVE TO NEAR-BY FEATURES, ALSO HOW TO REACH CORNER**

From Texas Bar, take Nye Creek Road S678. Go  $3\frac{1}{4}$  mile, turn left on jeep trail 1 mile, and corner is Southeast about 200 ft. from road on Southeast side of Camp Creek.

Signature

Party Chief

Title

Division

Krumbein Engineering

Headquarters

Date

*14 Sep 78*

7100-52-(3/68)

## CORNER RECORD (PERPETUATION)

GPO 802-673

MONUMENT: DESCRIBE NEW MONUMENT SET, OR WORK DONE TO PRESERVE EXISTING MONUMENT

T 6S R 33E

Set 2½" x 30" iron pipe with brass cap (stamped)

SE 1/16 S 31

Pipe is 21" in. in ground

1978  
PLS 933

9

ACCESSORIES: DESCRIBE NEW BT'S WITNESS OBJECTS ETC. ESTABLISHED, OR WORK DONE TO PRESERVE EXISTING EVIDENCE

Scribed two BTs.

Fir 12 in. diam. brs. S 15°49' W 32.75 ft. marked SE 1/16 S31 BT with signs 54-3, 54-4 and brass washer. Fir 13" diam. brs. N 84°32' E 15.20 ft. marked SE 1/16 S31 BT with signs 54-3, 54-4, and brass washer.

Set steel post 4 ft. with signs 54-2 and 54-4.

Painted scribed area and red band around trees.

10

Work Done By P. Murphy Title Party Chief Date 8/29/78 State Registration No. or Agency \_\_\_\_\_Certified Cor. Record Prepared? Yes  No \_\_\_\_\_ Filed At: County Surveyor Date \_\_\_\_\_ 11

## REMARKS

Witness by: R. Barton  
M. Murtishaw

12

Index File No. Y-4 T. 6S R. 33E M. Willamette Tract or Surv. No.

Cor.

13