

Index
File No. Z-11


CORNER RECORD (SEARCH)
(Ref. FSM 7151.4)

Tract or
Survey No. _____ Cor. No. Z-11

T 6S R. 33E
Merid. Williametta

R.D. Ukiah County _____
N.F. Vmⁿ Filla State Oregon

CORNER DIAGRAM

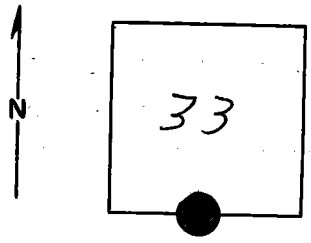

DESCRIBE CORNER MONUMENT FOUND

~~CR T7S, R33E A-11~~
Brass Cap; see Mon. File

DESCRIBE BEARING TREES OR OTHER OFFICIAL ACCESSORIES FOUND

PHOTO IDENTIFICATION DATA

Photo No. _____
Filed At. _____
Object Ident. _____
Ident. By _____
Signature

DESCRIBE CORNER LOCATION RELATIVE TO NEAR-BY FEATURES, ALSO HOW TO REACH CORNER

PLANE COORDINATE POSITION DATA

State _____ Zone _____
X _____
Y _____
Estab. By _____
Agency

Signature _____ Title _____ Division _____ Headquarters _____ Date _____

CORNER RECORD (PERPETUATION)

MONUMENT : DESCRIBE NEW MONUMENT SET, OR WORK DONE TO PRESERVE EXISTING MONUMENT

9

ACCESSORIES : DESCRIBE NEW BT'S WITNESS OBJECTS ETC. ESTABLISHED, OR WORK DONE TO PRESERVE EXISTING EVIDENCE

10

Work Done By _____ Title _____ Date _____ State Registration No. or Agency _____

Certified Cor. Record Prepared ? Yes No Filed At: _____ Date _____

11

REMARKS

Index File No. T. R. M. Tract or Surv. No. Cor.

12

13

015

Index File No. A-11

CORNER RECORD (SEARCH)

Tract or Survey No. Cor. No. A-11⁶


T 7S R. 33E

R.D. Ukiah County Umatilla

Merid. Will

N.F. Umatilla State Oregon

CORNER DIAGRAM

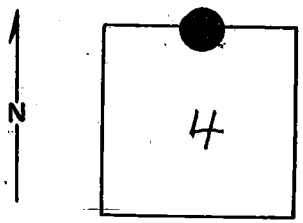

DESCRIBE CORNER MONUMENT FOUND

Found granite stone of proper dimensions in the proper location from BT, but could not distinguish scribing. Stone has been marked with yellow paint.

Brass Copi 500 Moni File

DESCRIBE BEARING TREES OR OTHER OFFICIAL ACCESSORIES FOUND

BT bearing $S 71^{\circ}E$, 94 lks from corner.
Other BT would be in road bed. No remains.

PHOTO IDENTIFICATION DATA

Photo No. EQD 7-211(9-1-66)

Filed At.

Object Ident. 20" Pine, 585' W, 73' W

Ident. By Tom Sutherland
Signature

DESCRIBE CORNER LOCATION RELATIVE TO NEAR-BY FEATURES, ALSO HOW TO REACH CORNER

Road approx. 1 ch. W. of corner.

PLANE COORDINATE POSITION DATA

State Zone

X

Y

Estab. By
Agency

Signature
Ken [unclear]

Title
Eng. Ade

Division
USFS

Headquarters
Umatilla-S.O., 7-28-69

Date

7100-52
REV. 65 5

CORNER RECORD (PERPETUATION)

MONUMENT: DESCRIBE NEW MONUMENT SET, OR WORK DONE TO PRESERVE EXISTING MONUMENT

ACCESSORIES : DESCRIBE NEW BT's, WITNESS OBJECTS ETC. ESTABLISHED, OR WORK DONE TO PRESERVE EXISTING EVIDENCE

Posted BT sign (54-3) and Attention sign (54-4) on BT.
Placed location poster on S. side of road. Corner is N 85° E, and
.90 Iks distant from location poster.

Work Done By MIKE LILLY Title ENR Aide Date 7/28/69 State Registration No. USFS
or Agency

Certified Cor. Record Prepared? Yes No Filed At: _____ Date _____

REMARKS
Identified area on photo by scaling E. from pin pricked NW
corner of sec. 4, T7S, R33E.

Index File No. A-11 T. 7S R. 33E M. Will. Tract or Surv. No.

Cor, A-11