


CORNER DIAGRAM

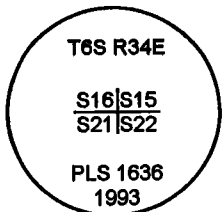

DESCRIBE CORNER MONUMENT FOUND

Found a 2 1/2" aluminum pipe, with a 3 1/4" aluminum cap, set flush with the ground surrounded by a small stone mound.

DESCRIBE BEARING TREES OR OTHER OFFICIAL ACCESSORIES FOUND

20" Western Larch, N. 28 1/2 E., 90.4 feet, with burnt out blaze.
 15" Western Larch, S. 55 E., 76.6 feet, with scribing visible on burnt double blaze.
 15" White Fir, S. 31 1/4 W., 28.3 feet, with scribing visible on double blaze.
 20" dead Western Larch, N. 18 1/2 W., 89.8 feet, with burnt out blaze.

PHOTO IDENTIFICATION DATA

Photo No.
 Filed At.
 Object Ident.
 Ident. By

Signature _____

DESCRIBE CORNER LOCATION RELATIVE TO NEAR-BY FEATURES, ALSO HOW TO REACH CORNER

PLANE COORDINATE POSITION DATA

State: Zone:

X:

Y:

Datum:

Signature
D. Schlaich

Title
Land Surveyor

Division

Headquarters
S.O.

Date
09/1997

CORNER RECORD (PERPETUATION)

MONUMENT: DESCRIBE NEW MONUMENT SET, OR WORK DONE TO PRESERVE EXISTING MONUMENT

ACCESSORIES: DESCRIBE NEW BT'S WITNESS OBJECTS ETC. ESTABLISHED, OR WORK DONE TO PRESERVE EXISTING EVIDENCE

RM, 5/8" X 24" rebar with red plastic cap stamped "UMATILLA N.F.", set 17" in the ground, N. 51 1/2 W., 32.9 feet.

Work Done By D. Schlaich Title Land Surveyor Date 09/1997 State Registration No. _____
or Agency _____
Certified Corner Record Prepared? Yes No Filed At: Umatilla County Surveyor's Office Date 11/1997

REMARKS

Index File No.

N-13

T. 6 S.

R. 34 E.

M. Willamette

Tract or Survey No.

Cor.

Index File No. N-13

CORNER RECORD (SEARCH)

(Ref. FSM 7151.4)

Tract or Survey No. _____ Cor. No. _____


T 65 R. 34E

R.D. NFJD County UMATILLA

Merid. WILL

N.F. UMATILLA State OREGON

CORNER DIAGRAM

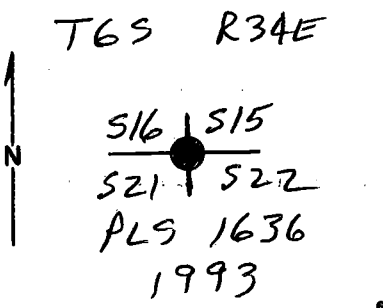

DESCRIBE CORNER MONUMENT FOUND

NONE

DESCRIBE BEARING TREES OR OTHER OFFICIAL ACCESSORIES FOUND

22" W. LARCH N26°45'E, 90.42 ft

20" W. LARCH N19°45'W, 89.76 ft

PHOTO IDENTIFICATION DATA

Photo No. _____

Filed At. _____

Object Ident. _____

Ident. By _____

Signature _____

DESCRIBE CORNER LOCATION RELATIVE TO NEAR-BY FEATURES, ALSO HOW TO REACH CORNER

50' NORTH OF A SMALL ROCKY SPUR RIDGE.

PLANE COORDINATE POSITION DATA

State _____ Zone _____

X _____

Y _____

Estab. By _____

Agency _____

Signature Hennis K. Gaylord Title _____ Division SO Headquarters _____ Date 9-1-93 FS-7100-52 (3/68)

CORNER RECORD (PERPETUATION)

MONUMENT: DESCRIBE NEW MONUMENT SET, OR WORK DONE TO PRESERVE EXISTING MONUMENT

SET 2 1/2" ALUM PIPE W/ 3/4" ALUM CAP MKD
AS SHOWN IN DIAGRAM

ACCESSORIES : DESCRIBE NEW BT'S WITNESS OBJECTS ETC. ESTABLISHED, OR WORK DONE TO PRESERVE EXISTING EVIDENCE

15" W. FIR S80°W, 29.8 FT
15" W. LARCH S56°E, 77.1 FT

Work Done By D. GAYLORD Title LS Date 9-1-93 State Registration No. 1636
or Agency

Certified Cor. Record Prepared? Yes No Filed At: UMATILLA CO Date 9-29-93

REMARKS

Index File No. N-13 T. 6S R. 34E M. WILL Tract or Surv. No. Cor. 13