

USDA-FOREST SERVICE

Index

File No.

T. 6 S. R. 35 E.

Merid. WILLAMETTE

CORNER RECORD (SEARCH)

(Ref. FSM 7151.4)

R.D. NFJD

N.F. UMATILLA

County UMATILLA

State OREGON


Tract or

Survey No. Tower Unit

Cor.

No. AP-454

CORNER DIAGRAM

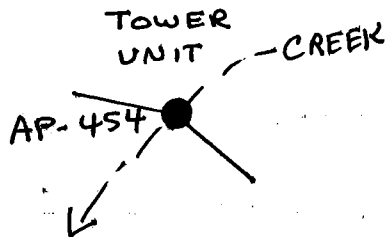

DESCRIBE CORNER MONUMENT FOUND

NONE

DESCRIBE BEARING TREES OR OTHER OFFICIAL ACCESSORIES FOUND

NONE

PHOTO IDENTIFICATION DATA

Photo No.:

Filed At:

Object Ident.:

Ident. By:

*Signature*

DESCRIBE CORNER RELATIVE TO NEAR-BY FEATURES, ALSO HOW TO REACH CORNER

The corner is located in an unnamed tributary of Big Creek at the toe of a spur ridge.

PLANE COORDINATE POSITION DATA

State: Oregon Zone: North

X: 2,496,431.45'

Y: 500,408.52'

Datum: NAD1927

Signature

D. Schlaich

Title

Land Surveyor

Division

Headquarters

S.O.

Date

07-1993

FS-7100-52 (3/68)

CORNER RECORD (PERPETUATION)

MONUMENT: DESCRIBE NEW MONUMENT SET, OR WORK DONE TO PRESERVE EXISTING MONUMENT

5/8" by 3/8" rebar, with a 3 1/4" aluminum cap, in the center of an unnamed tributary of Big Creek, marked "NFJD WILDERNESS TOWER UNIT AP-454 RLS2308 1993".

ACCESSORIES : DESCRIBE NEW BT's WITNESS OBJECTS ETC. ESTABLISHED, OR WORK DONE TO PRESERVE EXISTING EVIDENCE

9" Lodgepole Pine, S. 71° W., 56.6 ft., mkd. "WB/454"BT" on double blaze.

13" Englemann Spruce, N. 69° W., 55.0 ft., mkd. "WB/454"BT" on double blaze.

Work Done By **D. Schlaich**

Title Land Surveyor

Date 07-1993

State Registration No.  
or Agency

Certified Cor. Record Prepared ? NO

Filed At:

Date

REMARKS

Index File No.

T.

6 S.

R.

34 E.

M.

W.M.

Tract or Survey No.

Cor.

AP-454