

Index  
File No.

**CORNER RECORD (SEARCH)**  
(Ref. FSM 5151.4)

Tract or Survey No. **North Fork John Dav Unit** Cor. No. **AP-570**


T. 6 S. R. 34 E.

R.D. North Fork John Day County Umatilla

Merid. Willamette

N.F. Umatilla State Oregon

CORNER DIAGRAM

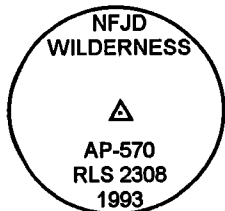

DESCRIBE CORNER MONUMENT FOUND

Found a 3 1/4" aluminum cap, 18" below the stream bed of winom creek.

DESCRIBE BEARING TREES OR OTHER OFFICIAL ACCESSORIES FOUND

6" Lodgepole Pine Snag, N. 10 1/2 W., 39.0 feet, with scribing visible on double blaze.

7" Lodgepole Pine Snag, N. 88 W., 43.0 feet, with scribing visible on double blaze.

PHOTO IDENTIFICATION DATA

Photo No.  
Filed At.  
Object Ident.  
Ident. By  
Signature

DESCRIBE CORNER LOCATION RELATIVE TO NEAR-BY FEATURES, ALSO HOW TO REACH CORNER

The corner is located at the confluence of an unnamed creek with Winom creek.

PLANE COORDINATE POSITION DATA

State: Zone:  
X:  
Y:  
Datum:

Signature

D. Schlaich

Title

Land Surveyor

Division

Headquarters

S.O.

Date

10/22/1997

FS-7100-52 (3/97)

CORNER RECORD (PERPETUATION)

MONUMENT: DESCRIBE NEW MONUMENT SET, OR WORK DONE TO PRESERVE EXISTING MONUMENT

ACCESSORIES: DESCRIBE NEW BT'S WITNESS OBJECTS ETC. ESTABLISHED, OR WORK DONE TO PRESERVE EXISTING EVIDENCE

RM, 5/8" X 36" rebar with red plastic cap stamped "UMATILLA N.F.", set 30" in the ground, S. 41 1/4 E., 52.8 feet.  
8" Lodgepole Pine, N. 67 1/2 W., 56.7 feet, scribed "WB/570" "BT" on double blaze.

Work Done By D. Schlaich Title Land Surveyor Date 10/22/1997 State Registration No. \_\_\_\_\_  
or Agency \_\_\_\_\_  
Certified Corner Record Prepared? Yes  No  Filed At: \_\_\_\_\_ Date \_\_\_\_\_

REMARKS

Index

File No.

T. 6 S. R. 34 E.

Merid. WILLAMETTE

CORNER RECORD (SEARCH)

(Ref. FSM 7151.4)

Tract or

Survey No. NFJD Unit

Cor.

No. AP-570


R.D. NFJD

N.F. UMATILLA

County UMATILLA

State OREGON

CORNER DIAGRAM

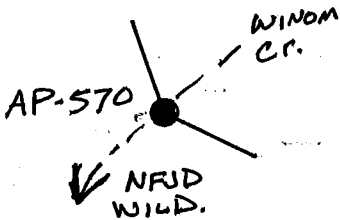

DESCRIBE CORNER MONUMENT FOUND

NONE

DESCRIBE BEARING TREES OR OTHER OFFICIAL ACCESSORIES FOUND

NONE

PHOTO IDENTIFICATION DATA

Photo No.:

Filed At:

Object Ident.:

Ident. By:

*Signature*

DESCRIBE CORNER RELATIVE TO NEAR-BY FEATURES, ALSO HOW TO REACH CORNER

The corner is located at the confluence of an unnamed creek with Winom creek.

PLANE COORDINATE POSITION DATA

State: Oregon Zone: North

X: 2,476,842.06'

Y: 494,938.36'

Datum: NAD1927

*Signature*

D. Schlaich

Title

Land Surveyor

Division

Headquarters

S.O.

Date

07-1993

FS-7100-52 (3/68)

CORNER RECORD (PERPETUATION)

MONUMENT: DESCRIBE NEW MONUMENT SET, OR WORK DONE TO PRESERVE EXISTING MONUMENT

5/8" by 36" rebar, with a 3 1/4" aluminum cap, flush with the water surface, marked "NFJD WILDERNESS AP-570 RLS 2308 1993".

ACCESSORIES: DESCRIBE NEW BT's WITNESS OBJECTS ETC. ESTABLISHED, OR WORK DONE TO PRESERVE EXISTING EVIDENCE

6" Lodgepole Pine, N. 10° E., 39.0 ft., mkd. "WB/570"BT" on double blaze.

6" Lodgepole Pine, N. 87° W., 43.0 ft., mkd. "WB/570"BT" on double blaze.

Both BT's have a 3/4" brass washer stamped "RLS 2308" nailed next to "BT" scribing on lower blaze.

Work Done By **D. Schlaich**

Title Land Surveyor

Date 07-1993

State Registration No.  
or Agency

Certified Cor. Record Prepared ? NO

Filed At:

Date

REMARKS

Index File No.

T.

6 S.

R.

34 E.

M.

W.M.

Tract or Survey No.

NFJD Unit

Cor.

AP-570