

Index
File No. 2-25

CORNER RECORD (SEARCH)
(Ref. FSM 7151.4)

Tract or
Survey No. SEC 36 Cor. No. SE COR


T 6S R. 33E

R.D. DALE County UMATILLA / GRANT CO. LINE

Merid. WILLAMETTE

N.F. UMATILLA State OREGON

CORNER DIAGRAM

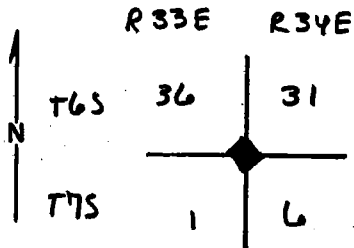

DESCRIBE CORNER MONUMENT FOUND

BASALT STONE 15 X 15 X 2 INCHES

DESCRIBE BEARING TREES OR OTHER OFFICIAL ACCESSORIES FOUND

4 BEARING TREES FOUND:

1. SPRUCE 10" DBH N 71°E 27 LKS (DOWN)
2. W. LARCH 17" DBH S 11°E 32 LKS (T7S, R34E)
3. W. LARCH 10" DBH S 30°W 3 LKS (T7S, R 34E - DOWN)
4. SPRUCE 19" DBH N 48°W 12 LKS (STUMP)

SECTION CORNER

PHOTO IDENTIFICATION DATA

Photo No. _____

Filed At. _____

Object Ident. _____

Ident. By _____

Signature

PLANE COORDINATE POSITION DATA

State _____ Zone _____

X _____

Y _____

Estab. By _____

Agency

Signature

Title

Division

Headquarters

Date

7100-52-(3/68)

1st FW FURST

10-23-22

CORNER RECORD (PERPETUATION)

MONUMENT: DESCRIBE NEW MONUMENT SET, OR WORK DONE TO PRESERVE EXISTING MONUMENT

ACCESSORIES : DESCRIBE NEW BT'S WITNESS OBJECTS ETC. ESTABLISHED, OR WORK DONE TO PRESERVE EXISTING EVIDENCE

Work Done By _____ Title _____ Date _____ State Registration No. or Agency _____

Certified Cor. Record Prepared ? Yes No Filed At: _____ Date _____

REMARKS

DATA TRANSFERRED FROM ORIGINAL DATA CARD (A-1 775 R 34E) ON 1-13-83

Index File No. 2-25 T. 6S R. 33E M. WILLAMETTE Tract or Surv. No.


Cor. SECTION 13
★U.S. G.P.O. 1977-725-576/586

LAND CORNER RECORD

44 5680-2
Dale 1

1. T. 6S R. 34E No. Z-1 Cor. Sec. Mer. W State Oregon (Rectangular) N. F. Umatilla Dist.

2. Corner Status

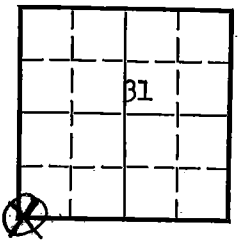

3. Original Description _____ Vol. _____ Page _____ Where Recorded _____

4. Description of Corners:
Corner consists of basalt stone in place, 15x15x12 inches

7. Photo Identification

Photo No. _____
Ident. By: _____

8. Plane Coordinate Position Data

State _____ Zone _____
X _____
Y _____
Estab. By _____
Field Book No. _____
Where Filed _____

9. Evaluation

Authentic _____
Needs Verif. Monument *NO*
Re-estab. _____ Survey _____
Land Status _____

5. Investigation Notes:

BT's
10" spruce bearing N. 71° E. .27 ch. - down
17" WL bearing S. 11° E. .32 ch.
10" WL bearing S. 30° W. .3 ch. - down
19" spruce bearing N. 48° W. .12 ch. - *stump left*
Believed to be a genuine land office corner

In creek bottom 1 ch. NW of an old sheep camp. Reblazed trees.

6. Signed F. W. Furst Title _____ Date Oct. 23, 1922

PERPETUATION RECORD

10. Monument:

11. Accessories

Field Book _____ Page _____

12. Set By _____ Title _____

License _____ Agency _____ Date _____

13. Recorded By _____ Volume _____ Page _____

(Agency)

(Date) (City) (County) (State)

14. Remarks:

Z-1