

Index

File No. A-15

CORNER RECORD (SEARCH)

(Ref. FSM 7151.4)

Tract or
Survey No. _____

Cor.
No. _____


T 7S R. 31E

R.D. DALE County GRANT

Merid: WILLAMETTE

N.F. UMATILLA State OREGON

CORNER DIAGRAM

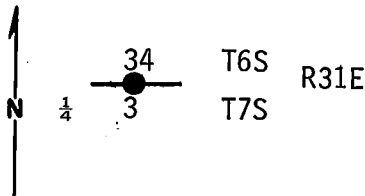

DESCRIBE CORNER MONUMENT FOUND

At the corner point, we find a 2½" Iron Pipe, extending 6" above ground, with brass cap attached, marked:

U.S. Dept. of the Interior
Bur. of Land Management

T6S R31E

¼ S34
|
¼ S3
|
¼ T7S

DESCRIBE BEARING TREES OR OTHER OFFICIAL ACCESSORIES FOUND

From which: The remains of the original BT's:

1980

A 26" D. Fir snag bears S55°W 19.1 ft., and a 20" rotten Pine stump bears N43°E 77.9 ft. And New BT's apparently marked by BLM, A 10" D. Fir, with scribing "¼ S34 BT" visible on a single blaze bears N6°E 45.9 ft. And a 12" D. Fir, with scribing "¼ S3 BT" visible on a single blaze bears S80°E 30.7 ft.

PHOTO IDENTIFICATION DATA

Photo No. 380-34

Filed At. UMATILLA N.F.

Object Ident. DIRECT

Ident. By [Signature]

PLANE COORDINATE POSITION DATA

State _____ Zone _____

X _____

Y _____

Estab. By _____

Agency

[Signature]

Title
PLS.

Division

Headquarters

Date

12-21-82

7100-52 (3-68)

CORNER RECORD (PERPETUATION)

MONUMENT: DESCRIBE NEW MONUMENT SET, OR WORK DONE TO PRESERVE EXISTING MONUMENT

ACCESSORIES: DESCRIBE NEW BY'S WITNESS OBJECTS ETC. ESTABLISHED, OR WORK DONE TO PRESERVE EXISTING EVIDENCE

Work Done By: GARY LANGLITZ Title: LAND SURVEYOR Date: 7-29-82 State Registration No. LS 1099
or Agency

Certified Cor. Record Prepared? Yes No Filed At: GRANT AND UMATILLA COUNTY Date 12-82

REMARKS

Staff Compass and Steel Tape.

Declination 19° East

July 29, 1982

Witnesses: Gary Langlitz
Jeff Anderson
Greg Orton

Index File No. A-15 T. 7S R. 31E M. WILLAMETTE Tract or Surv. No. Cor.

Index

File No. A-15

CORNER RECORD (SEARCH)

(Ref. FSM 7151.4)

Tract or

Survey No. SFC 3 Cor. No. N 1/4 COR.


T 7S R. 31E

R.D. DALE County GRANT / UMATILLA CO. LINE

Merid. WILLAMETTE

N.F. UMATILLA State OREGON

CORNER DIAGRAM

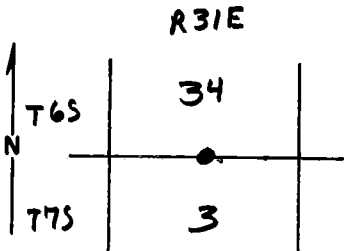

DESCRIBE CORNER MONUMENT FOUND

NONE

DESCRIBE BEARING TREES OR OTHER OFFICIAL ACCESSORIES FOUND

29" D. FIR SNAG - SW QUADRANT WITH NE BLAZE PARTLY OPEN AND SCRIBED: S INSIDE.

40" P. PINE - NE QUADRANT. NO EVIDENCE OF BLAZE BUT IT IS CORRECT BEARING AND APPROX. DIST. NO OTHER PINE WITHIN 80'.

PHOTO IDENTIFICATION DATA

Photo No. _____

Filed At. _____

Object Ident. _____

Ident. By _____

Signature

PLANE COORDINATE POSITION DATA

State _____ Zone _____

X _____

Y _____

Estab. By _____

Agency

Signature

B. MOORE

Title

ENG. TECH

Division

Headquarters

Date

3/78

7100-52 (3. 68)

CORNER RECORD (PERPETUATION)

MONUMENT: DESCRIBE NEW MONUMENT SET, OR WORK DONE TO PRESERVE EXISTING MONUMENT

ACCESSORIES : DESCRIBE NEW BT'S WITNESS OBJECTS ETC. ESTABLISHED, OR WORK DONE TO PRESERVE EXISTING EVIDENCE

I PLACED "ATTENTION" AND "BEARING TREE" POSTERS ON BOTH TREES. EAST, WEST FENCE AND F.S. BOUNDARY POSTERS 300' SOUTH OF 1/4 CORNER

Work Done By _____ Title _____ Date _____ State Registration No. _____
or Agency _____

Certified Cor. Record Prepared? Yes No Filed At: _____ Date _____

REMARKS

DATA COPIED FROM ORIG. FILE CARD ON 1-19-83

Index File No. A-15 T.7S R.31 M. WILLAMETTE Tract or Surv. No. SEC 3 Cor. N 1/4 COR 13