

USDA-FOREST SERVICE

Index

File No. 2-2

CORNER RECORD (SEARCH)

(Ref. FSM 7151.4)

Tract or

Survey No. SEC 31 Cor. No. S-W 1/16

T 6S R. 31E

R.D. DALE

County GRANT/UMATILLA CO. LINE


Merid. WILLAMETTE

N.F. UMATILLA

State OREGON

CORNER DIAGRAM

R31E

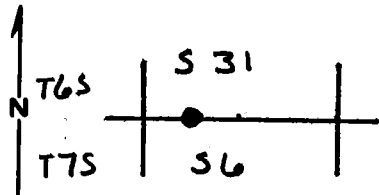

DESCRIBE CORNER MONUMENT FOUND NONE FOUND.  
SET BY SURVEY

CORNER POINT DETERMINED BY SURVEY AND PROPORTIONATE MEASUREMENT BETWEEN N 1/4 CORNER AND THE NW CORNER OF SECTION 6, T7S, R31E. SEE OTHER SIDE.

DESCRIBE BEARING TREES OR OTHER OFFICIAL ACCESSORIES FOUND  
N/A

W 1/16 CORNER

PHOTO IDENTIFICATION DATA

Photo No. \_\_\_\_\_

Filed At. \_\_\_\_\_

Object Ident. \_\_\_\_\_

Ident. By \_\_\_\_\_

Signature

PLANE COORDINATE POSITION DATA

State \_\_\_\_\_ Zone \_\_\_\_\_

X \_\_\_\_\_

Y \_\_\_\_\_

Estab. By \_\_\_\_\_

Agency

Signature

GARY L. LANGLITZ

Title

PLS

Division

Headquarters


Date

8-26-82

1100-52-(3.68)

**CORNER RECORD (PERPETUATION)**

**MONUMENT: DESCRIBE NEW MONUMENT SET, OR WORK DONE TO PRESERVE EXISTING MONUMENT**  
**SET 2" X 30" GALVANIZED IRON PIPE, 16" IN THE GROUND AND**  
**SUPPORTED IN A MOUND OF STONE 4 FT. DIAM. BASE TO TOP OF**  
**PIPE, WITH BRASS CAP ATTACHED, MARKED AS SHOWN:**

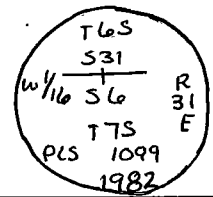

**FROM WHICH WE MARK THE FOLLOWING BT'S**

**ACCESSORIES: DESCRIBE NEW BT'S WITNESS OBJECTS ETC. ESTABLISHED, OR WORK DONE TO PRESERVE EXISTING EVIDENCE**

17" P. PINE SCRIBED "W 1/16 S31 BT" ON A DOUBLE BLAZE BR S N 71 1/4° W 33.0 FT.  
 22" P. PINE SCRIBED "W 1/16 S6 BT" ON A DOUBLE BLAZE BR S 13 1/2° W 32.2 FT.  
 ATTACHED BRASS WASHER MARKED "LS 1099" TO LOWER BLAZE OF NEW BT'S.

Work Done By: GARY L. LANGLITZ Title PLS Date 8-26-82 State Registration No. PLS 1099  
 or Agency

Certified Cor. Record Prepared?  Yes No Filed At: YAMATILLA AND GRANT COUNTY Date 12-82

WITNESSES: GREG ORTON  
JEFF ANDERSON

REMARKS

INFO COPIED FROM "LAND CORNER MONUMENTATION" FILE

Index File No. 2-2 T. 8S R. 31E M. WILL Tract or Surv. No. SEC 31 Cor. S-W 1/16