


Index File No. B-18
 T 7 S R. 32 E
 Merid. Willamette

CORNER RECORD (SEARCH)
 (Ref. FSM 7151.4)

Tract or Survey No. _____
 Cor. No. B-18

R.D. Dale County Grant
 N.F. Umatilla State Oregon

CORNER DIAGRAM

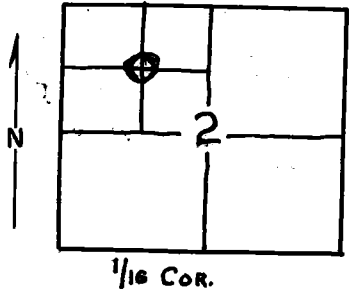

DESCRIBE CORNER MONUMENT FOUND

3 1/2 foot high wooden stake with squared top.

DESCRIBE BEARING TREES OR OTHER OFFICIAL ACCESSORIES FOUND

7 inch W. Fir with poster on east side which reads 220° - 6 feet to corner 1/16.

Also there are Boundry signs running north and south.

PHOTO IDENTIFICATION DATA

Photo No. _____
 Filed At. _____
 Object Ident. _____
 Ident. By _____
 Signature _____

DESCRIBE CORNER LOCATION RELATIVE TO NEAR-BY FEATURES, ALSO HOW TO REACH CORNER

1/16th. corner is 20 yds. north of a logging spur that originates from the Turner Basin road. S-747.

PLANE COORDINATE POSITION DATA

State _____ Zone _____
 X _____
 Y _____
 Estab. By _____
 Agency _____

Signature
Tom Twitchell

Title
Forestry tech. Timber

Division
Headquarters dale

Date
12-23-69

7100-52 (3/68)

4

CORNER RECORD (PERPETUATION)

MONUMENT: DESCRIBE NEW MONUMENT SET, OR WORK DONE TO PRESERVE EXISTING MONUMENT

9

ACCESSORIES : DESCRIBE NEW BT'S WITNESS OBJECTS ETC. ESTABLISHED, OR WORK DONE TO PRESERVE EXISTING EVIDENCE

10

Work Done By _____ Title _____ Date _____ State Registration No. or Agency _____

Certified Cor. Record Prepared ? Yes No Filed At: _____ Date _____

11

REMARKS

12

Index File No. B-18 T. 7S R. 32E B-18-SEC. 2 Tract or Surv. No. _____ Cor. _____

13