


USDA-FOREST SERVICE

Index  
 File No. C-14  
 T 7S R. 32E R.D. John Day County Grant Tract or Survey No. \_\_\_\_\_ Cor. No. \_\_\_\_\_  
 Merid. W.M. N.F. Umatilla State Or.

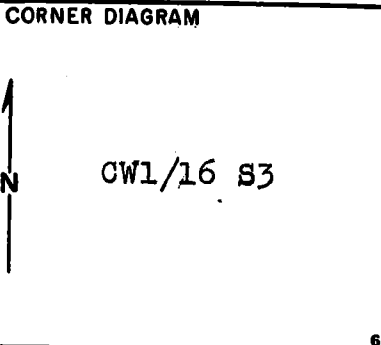

1 DESCRIBE CORNER MONUMENT FOUND  
 2 1/2" iron pipe with 3 1/4" brass cap (BLM) mkd.: W1/16 C S3 1968 C

2 DESCRIBE BEARING TREES OR OTHER OFFICIAL ACCESSORIES FOUND  
 W. Fir, 9", N38°E, 41 lks.; with healed blaze.  
 D. Fir, 14", S80°E, 30 1/2 lks.; " " "

6 PHOTO IDENTIFICATION DATA  
 Photo No. \_\_\_\_\_  
 Filed At. \_\_\_\_\_  
 Object Ident. \_\_\_\_\_  
 Ident. By \_\_\_\_\_  
 Signature \_\_\_\_\_ 7

3 DESCRIBE CORNER LOCATION RELATIVE TO NEAR-BY FEATURES, ALSO HOW TO REACH CORNER  
 Corner falls on NELY slope. Follow posted line from rd. to W.

8 PLANE COORDINATE POSITION DATA  
 State \_\_\_\_\_ Zone \_\_\_\_\_  
 X \_\_\_\_\_  
 Y \_\_\_\_\_  
 Estab. By \_\_\_\_\_  
 Agency \_\_\_\_\_

Signature F. P. Munro Title PLS Division \_\_\_\_\_ Headquarters \_\_\_\_\_ Date 7/11/90 FS-7100-52 (3/68) 5

CORNER RECORD (PERPETUATION)

MONUMENT : DESCRIBE NEW MONUMENT SET, OR WORK DONE TO PRESERVE EXISTING MONUMENT

None..

9

ACCESSORIES : DESCRIBE NEW BT's WITNESS OBJECTS ETC. ESTABLISHED, OR WORK DONE TO PRESERVE EXISTING EVIDENCE

None..

10

Work Done By. F.S. Munro Title PLS Date 7/7/90 State Registration No. 1832  
or Agency

Certified Cor. Record Prepared ? Yes No  Filed At: \_\_\_\_\_ Date \_\_\_\_\_

REMARKS

12

Index File No. C-14T. 7S R. 32E M. W.M.. Tract or Surv. No. \_\_\_\_\_ Cor. \_\_\_\_\_

13