

USDA-FOREST SERVICE

INDEX

CORNER RECORD (SEARCH)
(Ref. FSM 7151.4)

Tract or
Survey No. _____ Cor.
No. _____

FILE NO. C-17

T. 7 S R. 32 E R.D. North Fork John Day County Grant

Merid. Willamette N.F. UMATILLA State Oregon

CORNER DIAGRAM

1 DESCRIBE CORNER MONUMENT FOUND

1 Found standard BLM brass cap stamped as shown in the diagram.

1 1/4 1

N 53 1 52 1

1 T75R32E 1

1 1967 1

2

PHOTO IDENTIFICATION DATA

1 DESCRIBE BEARING TREES OR OTHER OFFICIAL ACCESSORIES FOUND

1 A 11" dbh White Fir bears S80 1/2°E, 4.3' with healed blaze.

1 A 14" dbh White Fir bears S46°W, 5.6' with healed blaze.

Photo No. _____ 1

Filed at. _____ 1

Object Ident. _____ 1

Ident. By _____ 1

Signature _____ 1

3

PLANE COORDINATE POSITION DATA

1 DESCRIBE CORNER LOCATION RELATIVE TO NEAR-BY FEATURES, ALSO HOW TO REACH CORNER

State _____ Zone _____ 1 Follow FSR 55 from Highway 395 to FSR 5505. Follow FSR 5505 2 miles. Cross a cattle guard

x _____ 1 and turn west after 100 yards. Follow this primitive road 1 mile around a steep hill and then

Y _____ 1 up a steep grade for 0.6 mile to a junction. Follow the east fork of the road 0.3 mile to a

Estab. By _____ 1 junction. Take the south fork of the road 0.5 mile to a junction. The corner is located S45°W

Agency _____ 1 from this junction.

4

Signature David L. Harold Title Surveyor Division _____ Headquarters Pendleton, OR Date FS-7100-52 (3/68)
2-15-94

5

CORNER RECORD (PERPETUATION)

MONUMENT : DESCRIBE NEW MONUMENT SET, OR WORK DONE TO PRESERVE EXISTING MONUMENT

Cleared brush and debris away from corner.

9

ACCESSORIES : DESCRIBE NEW BT'S WITNESS OBJECTS ETC. ESTABLISHED, OR WORK DONE TO PRESERVE EXISTING EVIDENCE

Set new bearing trees.

A 10" dbh White Fir bears N42°E, 41.2' scribed 1/4 S2 BT.

A 21" dbh Ponderosa Pine bears N19 1/4°W, 111.7' scribed 1/4 S3 BT.

An aluminum washer stamped RLS 852 is nailed between the letters B and T on each new tree. BT and LSM signs are attached to each bearing tree. Six inch red bands are painted around each bearing tree and the blazes are painted red.

10

Work Done By. David L. Haddock Title Land Surveyor Date 9-21-93 or Agency PLS 852 State Registration No.
Certified Cor. Record Prepared? x Yes No Filed At: Grant County Surveyor Date 11-93 11

REMARKS

12

Index File No. C-17 T. 7 S. R. 32 E. M. Willamette Tract or Surv. No. Cor. 13

Index File No. C-17


CORNER RECORD (SEARCH)

(Ref. FSM 7151.4)

Tract or Survey No. _____
Cor. No. 8

T 7 S R. 32 E R.D. Dale County Grant
Merid. Willamette N.F. Umatilla State Oregon

CORNER DIAGRAM

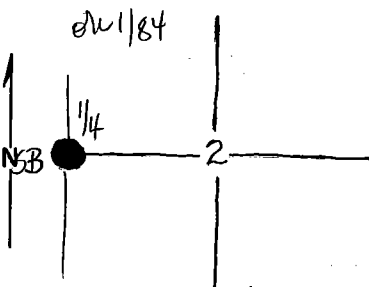

DESCRIBE CORNER MONUMENT FOUND

Brass Cap - $3\frac{1}{4}$ " dia. - 1" high, good condition.
Markings - $\frac{1}{4}$ C - sec 3 & 2 T7S, R32E (1967) BLM-Dept. Int. Cadastral Survey.

DESCRIBE BEARING TREES OR OTHER OFFICIAL ACCESSORIES FOUND

Bearing Tree - 6 feet west of haul road - 18" DBH Ponderosa Pine
G.P. metal tag - T7S, R32E. approx 2 ch. south to $\frac{1}{4}$ cor. L.L. - HBS.
Bearing Tree - White Fir 8" DBH - can be seen from haul road.
metal tag 54-3, N 46 E, Sec. 3 - JET 1967 - Blaze NE side ~~near~~
near ground. 8 1/2 lks. T. 7S, R. 32E.

PHOTO IDENTIFICATION DATA

Photo No. EXR-78-4-234
Filed At. 2210 CENTRAL-DESOL. C+H
Object Ident. Photo Print
Ident. By [Signature] 8-10-71
[Signature]

Range office

PLANE COORDINATE POSITION DATA

State _____ Zone _____
X _____
Y _____
Estab. By _____
Agency

DESCRIBE CORNER LOCATION RELATIVE TO NEAR-BY FEATURES, ALSO HOW TO REACH CORNER

Bearing Tree - Blaze NW side near ground. Metal tag 54-3. N $80\frac{1}{2}$ W
 $6\frac{1}{2}$ links. section 2, JET, 1967 12" Fir DBH, also Property Boundary
sign, metal, form 1505 easily seen from haul road.

Bearing log - Blaze NW side - Larch, approx. 30" DBH, Metal Tag
54-3 - Corner approx. 15 links N 35 W

Signature

Emery Swann

Title

Range Commr.

Division

Range

Headquarters

Dale

Date

9-20-72

7100-52 (3/68)

CORNER RECORD (PERPETUATION)

MONUMENT: DESCRIBE NEW MONUMENT SET, OR WORK DONE TO PRESERVE EXISTING MONUMENT

Property Boundary Marker - Metal - form 1505 - W. Fir 4" DBH - Blazed on tree (two sides)
25 feet N.W. of Brass Cap. easily seen from road.

Ponderosa Pine - 18" DBH Branded *S* NE side. letter 18" high by 9" wide. approx. 30
feet NW of Brass Cap.

9

ACCESSORIES : DESCRIBE NEW BT's WITNESS OBJECTS ETC. ESTABLISHED, OR WORK DONE TO PRESERVE EXISTING EVIDENCE

10

Work Done By _____ Title _____ Date _____ State Registration No.
or Agency _____

Certified Cor. Record Prepared ? Yes No Filed At: _____ Date _____ 11

REMARKS


12

Index File No. C-17 T. 75 R. 32 E #56C 2 Tract or Surv. No. Cor, 13

LAND CORNER RECORD
(Rectangular)

1. T 75 R 32E No. 017 Cor. 1/4 Mer. U.M. State Oregon N. F. Umatilla Dist. Dale 8

2. Corner Status

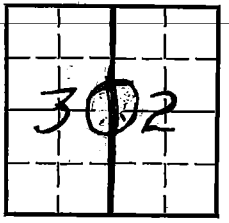

7. Photo Identification

Photo No. _____
Ident. By: _____

8. Plane Coordinate Position Data

State _____ Zone _____
X _____
Y _____
Estab. By _____
Field Book No. _____
Where Filed _____

9. Evaluation

Authentic _____
Needs Verif. Monument NO
Re-estab. _____ Survey _____
Land Status _____

3. Original Description _____ Vol. _____ Page _____ Where Recorded _____

4. Description of Corners: *Originally a fir post. Post is gone now. Originally there where two Larch BT's, one a 40" DBH and one a 4" DBH. The larger one is dead but still standing - it is closer to 30" - the smaller one is gone.*

5. Investigation Notes: *I walked down the trail on the east side of Trough Cr. to the first saddle. I found some flagging and a stake on the trail. I followed plastic flagging 2 1/2 chains to the area of the corner and found a G.P. ericiser's tag on the ground. I reset this on a small tree near the corner and put up a BT shield sign on the one remaining BT.*

6. Signed [Signature] Title T.M.A Date 6-12-67

PERPETUATION RECORD

10. Monument:

11. Accessories

		Field Book _____	Page _____
12. Set By _____	Title _____	13. Recorded By _____	Volume _____
License _____	Agency _____	(Agency)	Page _____
Date _____		(Date) _____	(City) _____
		(County) _____	(State) _____

14. Remarks: