

Index

File No.

T. 7 S.

R. 33 E.

Merid. WILLAMETTE

CORNER RECORD (SEARCH)

(Ref. FSM 7151.4)

R.D. NORTH FORK JOHN DAY

County GRANT

N.F. UMATILLA

State OREGON


Tract or

Survey No. NFJD UNIT

Cor.

No. AP-3455

CORNER DIAGRAM

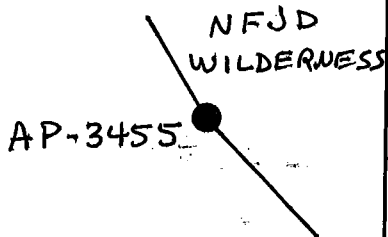

DESCRIBE CORNER MONUMENT FOUND

NONE:

DESCRIBE BEARING TREES OR OTHER OFFICIAL ACCESSORIES FOUND

NONE:

PHOTO IDENTIFICATION DATA

Photo No.:

Filed At.:

Object Ident.:

Ident. By:

Signature

DESCRIBE CORNER RELATIVE TO NEAR-BY FEATURES, ALSO HOW TO REACH CORNER

From the jct of roads 1012 and 5505, walk northerly approx. 200 feet to AP-3475. From AP-3475 walk N. 64° E., approx. 1350 feet to the corner.

PLANE COORDINATE POSITION DATA

State: Oregon Zone: North

X: 2,460,549.46'

Y: 474,046.78'

Datum: NAD1927

Signature

D. Schlaich

Title

Land Surveyor

Division

Headquarters

S.O.

Date

09/1993

FS-7100-52 (3/68)

CORNER RECORD (PERPETUATION)

MONUMENT: DESCRIBE NEW MONUMENT SET, OR WORK DONE TO PRESERVE EXISTING MONUMENT

Set a 5/8" by 3/8" rebar, with a 3 1/4" aluminum cap, flush with the ground, mkd. "NFJD WILDERNESS AP-3455 RLS 2308 1993".

ACCESSORIES : DESCRIBE NEW BT's WITNESS OBJECTS ETC. ESTABLISHED, OR WORK DONE TO PRESERVE EXISTING EVIDENCE

13" Western Larch, N. 5° E., 94.3 ft., mkd. "WB/3455""BT".

12" Western Larch, S. 78° E., 96.6 ft., mkd. "WB/3455""BT".

Both BT's are double blazed and have a 3/4" brass washer mkd. "RLS 2308" nailed to the lower blaze by the "BT" scribing.

Work Done By **D. Schlaich**

Title **Land Surveyor**

Date **09/1993**

State Registration No.
or Agency

Certified Cor. Record Prepared ? **NO**

Filed At

Date

REMARKS

Index File No.

T.

7 S.

R.

33 E.

M.

W.M.

Tract or Survey No.

NFJD UNIT

Cor.

AP-3455