

Index

File No.

T. 7 S.

R. 33 E.

Merid. WILLAMETTE

CORNER RECORD (SEARCH)

(Ref. FSM 7151.4)

R.D. NORTH FORK JOHN DAY

County GRANT

N.F. UMATILLA

State OREGON


Tract or

Survey No. NFJD UNIT

Cor.

No. AP-3421

CORNER DIAGRAM

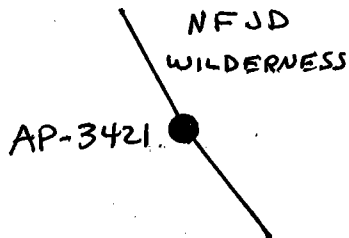

DESCRIBE CORNER MONUMENT FOUND

NONE:

DESCRIBE BEARING TREES OR OTHER OFFICIAL ACCESSORIES FOUND

NONE:

PHOTO IDENTIFICATION DATA

Photo No.:

Filed At.:

Object Ident.:

Ident. By:

Signature

PLANE COORDINATE POSITION DATA

State: Oregon Zone: North

X: 2,462,806.43'

Y: 470,227.21'

Datum: NAD1927

DESCRIBE CORNER RELATIVE TO NEAR-BY FEATURES, ALSO HOW TO REACH CORNER

From the jct of roads 1010 and 5505, travel northerly on road 5505 approx. 2.10 miles. Then walk East approx. 1100 feet to abandon road 5505-165. Then walk northerly, on the abandon road, approx. 2700 feet. The corner is located 100 feet easterly of the abandon road.

Signature

D. Schlaich

Title

Land Surveyor

Division

Headquarters

S.O.

Date

07/1993

FS-7100-52 (3/68)

CORNER RECORD (PERPETUATION)

MONUMENT: DESCRIBE NEW MONUMENT SET, OR WORK DONE TO PRESERVE EXISTING MONUMENT

Set a 5/8" by 36" rebar, with a 3 1/4" aluminum cap, 32" in the ground, mkd. "NFJD WILDERNESS AP-3421 RLS 2308 1993".

ACCESSORIES: DESCRIBE NEW BT's WITNESS OBJECTS ETC. ESTABLISHED, OR WORK DONE TO PRESERVE EXISTING EVIDENCE

6" Lodgepole Pine, N. 2° E., 15.6 ft., mkd. "WB/3421""BT".

11" Western Larch, WEST, 59.2 ft., mkd. "WB/3421""BT".

Both BT's are double blazed and have a 3/4" brass washer mkd. "RLS 2308" nailed to the lower blaze by the "BT" scribing.

Work Done By **D. Schlaich**

Title **Land Surveyor**

Date **07/1993**

State Registration No.
or Agency

Certified Cor. Record Prepared? **NO**

Filed At:

Date

REMARKS

Index File No.

T.

7 S.

R.

33 E.

M.

W.M.

Tract or Survey No.

NFJD UNIT

Cor.

AP-3421