

USDA-FOREST SERVICE

Index

File No.

T. 7 S. R. 33 E.

Merid. WILLAMETTE

CORNER RECORD (SEARCH)

(Ref. FSM 7151.4)

R.D. NORTH FORK JOHN DAY

County GRANT

N.F. UMATILLA

State OREGON


Tract or

Survey No. NFJD UNIT

Cor.

No. AP-3302A

CORNER DIAGRAM

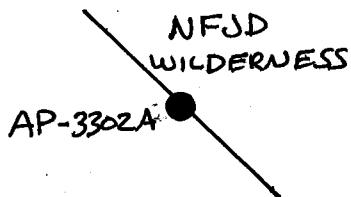

DESCRIBE CORNER MONUMENT FOUND

NONE:

DESCRIBE BEARING TREES OR OTHER OFFICIAL ACCESSORIES FOUND

NONE:

PHOTO IDENTIFICATION DATA

Photo No.:

Filed At:

Object Ident.:

Ident. By:

Signature

PLANE COORDINATE POSITION DATA

State: Oregon Zone: North

X: 2,471,346.78'

Y: 462,044.34'

Datum: NAD1927

DESCRIBE CORNER RELATIVE TO NEAR-BY FEATURES, ALSO HOW TO REACH CORNER

From the jct of road 5505 and trail 3007 travel easterly on the trail approx. 8300 feet to AP-3303 which is set on the trail. From AP-3303 walk, following the marked wilderness boundary, S. 61 1/2° W., 1460 feet to the corner.

Signature

D. Schlaich

Title

Land Surveyor

Division

Headquarters

S.O.

Date

05/25/93

FS-7100-52 (3/68)

CORNER RECORD (PERPETUATION)

MONUMENT: DESCRIBE NEW MONUMENT SET, OR WORK DONE TO PRESERVE EXISTING MONUMENT

Set a 5/8" by 36" rebar, with a 3 1/4" aluminum cap, flush with the ground, mkd. "NFJD WILDERNESS AP-3302A RLS 2308 1993".

ACCESSORIES : DESCRIBE NEW BT's WITNESS OBJECTS ETC. ESTABLISHED, OR WORK DONE TO PRESERVE EXISTING EVIDENCE

8" Douglas Fir, S. 4° W., 29.1 ft., mkd. "WB/3302A""BT".

8" Douglas Fir, S. 73 1/2° E., 12.9 ft., mkd. "WB/3302A""BT".

Both BT's are double blazed and have a 3/4" brass washer mkd. "RLS 2308" nailed to the lower blaze by the "BT" scribing.

Work Done By **D. Schlaich**

Title **Land Surveyor**

Date **05/25/93**

State Registration No.
or Agency

Certified Cor. Record Prepared ? **NO**

Filed At:

Date

REMARKS

Index File No.

T.

7 S.

R.

33 E.

M.

W.M.

Tract or Survey No.

NFJD UNIT

Cor.

AP-3302A