

Index  
File No. \_\_\_\_\_

CORNER RECORD (SEARCH)

(Ref. FSM 7151.4)

Tract or Survey No. NFJD WILD NFJD UNIT Cor. No. 1


T 7S R. 33E

R.D. NORTH FORK JOHN DAY County GRANT

Merid. WILLAMETTE

N.F. UMATILLA State OREGON

CORNER DIAGRAM

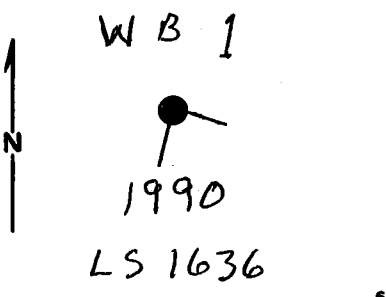

DESCRIBE CORNER MONUMENT FOUND

N/A

DESCRIBE BEARING TREES OR OTHER OFFICIAL ACCESSORIES FOUND

N/A

PHOTO IDENTIFICATION DATA

Photo No. \_\_\_\_\_  
Filed At. \_\_\_\_\_  
Object Ident. \_\_\_\_\_  
Ident. By \_\_\_\_\_  
*Signature*

DESCRIBE CORNER LOCATION RELATIVE TO NEAR-BY FEATURES, ALSO HOW TO REACH CORNER

PLANE COORDINATE POSITION DATA

State \_\_\_\_\_ Zone \_\_\_\_\_  
X \_\_\_\_\_  
Y \_\_\_\_\_  
Estab. By \_\_\_\_\_  
*Agency*

Signature

Title

Division

Headquarters

Date

FS-7100-52 (3/68)

**CORNER RECORD (PERPETUATION)**

**MONUMENT: DESCRIBE NEW MONUMENT SET, OR WORK DONE TO PRESERVE EXISTING MONUMENT**

SET 2 1/2" ALUM PIPE w/ 3 1/2" ALUM CAP AT HIGH WATER LINE OF NFJD RIVER AT POINT OTTER CREEK ENTERS RIVER. CAP IS MARKED AS IN CORNER DIAGRAM

**ACCESSORIES : DESCRIBE NEW BT'S WITNESS OBJECTS ETC. ESTABLISHED, OR WORK DONE TO PRESERVE EXISTING EVIDENCE**

18" W. LARCH N73° 30' W, 37.8 ft

12" W. FIR S60° W, 19.3 ft

BLAZED & SCRIBED "WB 1 BT" ON DOUBLE BLAZES & HAVE A 3/4" BRASS WASHER MARKED "PLS 1636" NAILED TO BLAZE & 54-3 & 54-9 SIGNS ATTACHED.

Work Done By. D. GAYLORD Title FOREST L.S. Date 8-16-90 State Registration No. 1636  
or Agency

Certified Cor. Record Prepared?  (Yes) ~~NO~~ Filed At: F.S. FILE 2320 Date 12-17-1990

REMARKS

Index File No.      T.      R.      M.      Tract or Surv. No.      Cor.      12