

USDA-FOREST SERVICE

Index
File No. B-19

CORNER RECORD (SEARCH)

(Ref. FSM 7151.4)

Tract or
Survey No. _____ Cor.
No. _____

T 7 S. 5 R. 34 E.


R.D. NORTH FORK JOHN DAY County GRANT

Merid. WILLAMETTE

N.F. UMATILLA State OREGON

CORNER DIAGRAM

CN 1/16

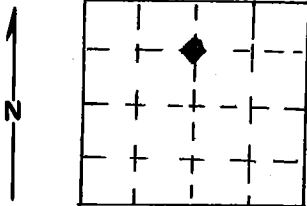

DESCRIBE CORNER MONUMENT FOUND

NONE

DESCRIBE BEARING TREES OR OTHER OFFICIAL ACCESSORIES FOUND

NONE

PHOTO IDENTIFICATION DATA

Photo No. _____

Filed At. _____

Object Ident. _____

Ident. By _____

Signature

PLANE COORDINATE POSITION DATA

State _____ Zone _____

X _____

Y _____

Estab. By _____

Agency

DESCRIBE CORNER LOCATION RELATIVE TO NEAR-BY FEATURES, ALSO HOW TO REACH CORNER

TAKE ROAD 5225 TO ROAD 510, GO 1/4 MILE TO CN 1/4 COR. ON LEFT, ABOUT 300 FT. FROM ROAD. GO NORTH 1/4 MILE TO CN 1/16 COR.

Signature

Title

Division

Headquarters

Date

FS-7100-52 (3/68)

*Clayton J. M...
LAND SURVEYOR*

10/25/66

CORNER RECORD (PERPETUATION)

MONUMENT: DESCRIBE NEW MONUMENT SET, OR WORK DONE TO PRESERVE EXISTING MONUMENT

SET A 2 1/2" DIAM. ALUM. CAP ON A 2 1/2" X 30" ALUM. PIPE W/FLARE AT BOTTOM AT POINT FOR CORNER. CAP MKD. PER SKETCH.

SET STEEL POSTS 4 1/2' E. & S. W/PROP. BNDRY, ATTN. & MON. SIGNS ATTACHED.

C
N 1/16 | S2
C
RPLS 1910
1986

9

ACCESSORIES : DESCRIBE NEW BT'S WITNESS OBJECTS ETC. ESTABLISHED, OR WORK DONE TO PRESERVE EXISTING EVIDENCE

- ① 9" D.B.H. LODGEPOLE PINE, N. 44 1/2° E., 97.1', SCRIBED CN 1/16 S2 BT.
- ② 15" D.B.H. DOUGLAS FIR, N. 3° W., 63.8', SCRIBED CN 1/16 S2 BT.
SET BRASS WASHER MKD. RPLS 1910 BTWN. BET ON EACH B.T., SET B.T. TAGS, ATTN. SIGNS, PAINTED BANDS AND FACES RED.

10

Work Done By CJ. MARTIN Title LAND SURVEYOR Date 10/25/86 State Registration No. LS 1910 or Agency

Certified Cor. Record Prepared? Yes No Filed At: Date

11

REMARKS

12

Index File No. B-19 T. 7 S. R. 34 E. M. WILLAMETTE Tract or Surv. No. Cor. CN 1/16

13