

Index

File No.

T. 7 S. R. 35 E.

Merid. WILLAMETTE

CORNER RECORD (SEARCH)

(Ref. FSM 7151.4)

R.D. NOTH FORK JOHN DAY

N.F. UMATILLA

County GRANT

State OREGON


Tract or

Survey No. **NFJD UNIT**

Cor.

No. **AP-1326**

CORNER DIAGRAM

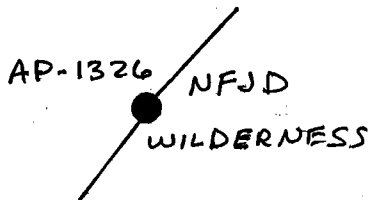

DESCRIBE CORNER MONUMENT FOUND

NONE

DESCRIBE BEARING TREES OR OTHER OFFICIAL ACCESSORIES FOUND

NONE

PHOTO IDENTIFICATION DATA

Photo No.:

Filed At.:

Object Ident.:

Ident. By:

Signature

DESCRIBE CORNER RELATIVE TO NEAR-BY FEATURES, ALSO HOW TO REACH CORNER

From the jct of road 52 and F.S. trail 3021 (Martin creek) go westerly on the trail approx 2.72 miles. The corner is located southeast of the trail 100 feet.

PLANE COORDINATE POSITION

State: Oregon Zone: North

X: 2,517,045.32'

Y: 480,512.07'

Datum: NAD1927

Signature

D. Schlaich

Title

Land Surveyor

Division

Headquarters

S.O.

Date

10/1993

FS-7100-52 (3/68)

CORNER RECORD (PERPETUATION)

MONUMENT: DESCRIBE NEW MONUMENT SET, OR WORK DONE TO PRESERVE EXISTING MONUMENT

Set at a point 100 feet southerly of and perpendicular to the centerline of trail 3021, a 5/8" by 36" rebar, with a 3 1/4" aluminum cap, 32" in the ground, mkd. "NFJD WILDERNESS AP-1326 RLS 2308 1993"

ACCESSORIES: DESCRIBE NEW BT's WITNESS OBJECTS ETC. ESTABLISHED, OR WORK DONE TO PRESERVE EXISTING EVIDENCE

Steel Fence post, with Land Survey Monument sign, N 33° W, 20.3 feet.

Steel Fence post, with Land Survey Monument & Wilderness Boundary signs, S 57° W, 11.5 feet.

Work Done By **D. Schlaich**

Title **Land Surveyor**

Date **10/1993**

State Registration No.
or Agency

Certified Cor. Record Prepared ? **NO**

Filed At:

Date

REMARKS

Index File No.

T.

7 S.

R.

35 E.

M.

W.M.

Tract or Survey No.

NFJD UNIT

Cor.

AP-1326