


Township N^o 2 North, Range N^o 30 East, Willamette Meridian.

3944

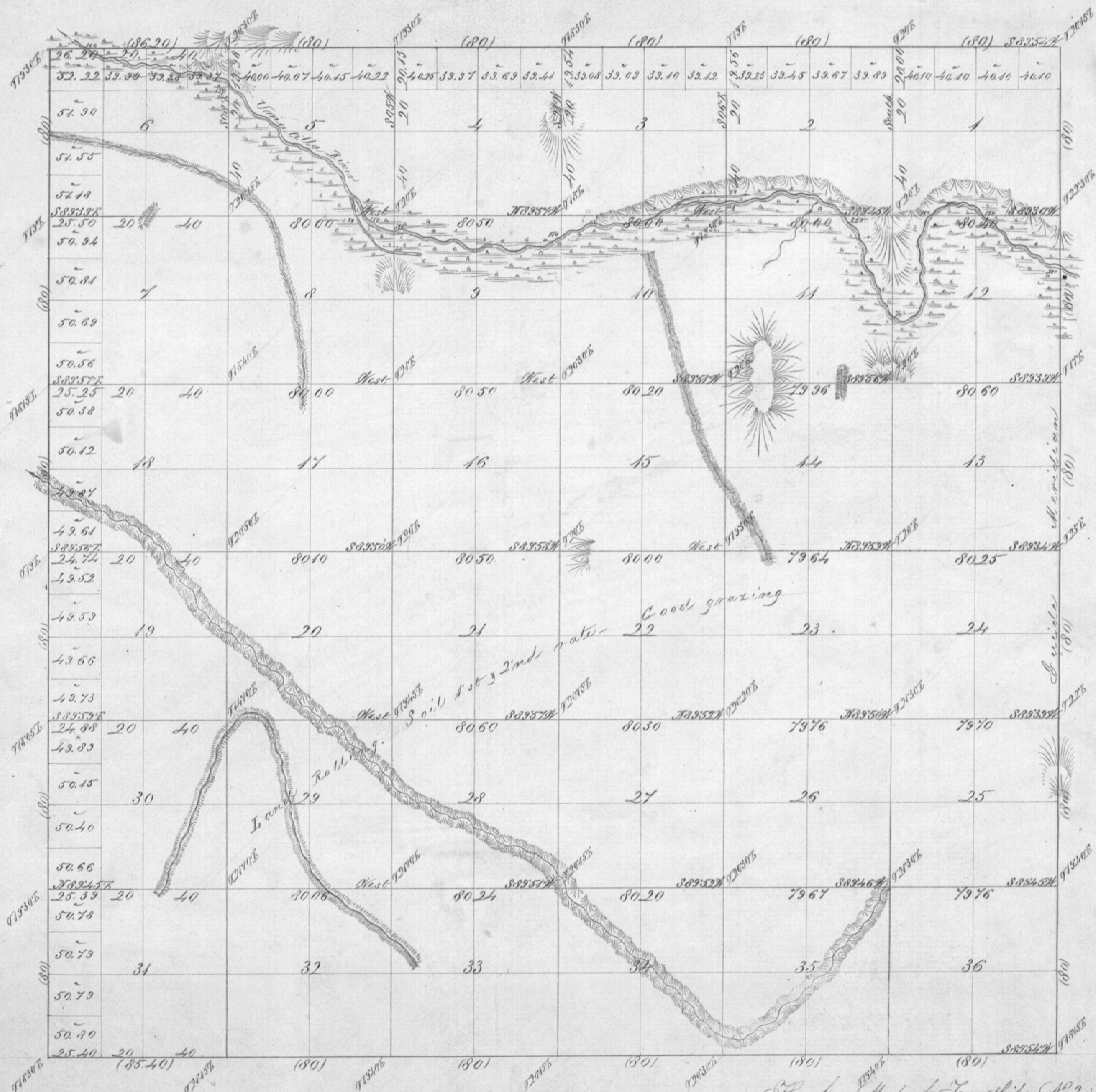

Surveys designated.	By whom surveyed.	Contract		Acut of survey.		
		No.	Date.	Acres.	Chains.	Links.
Township Lines	David P. Thompson	83	July 22nd 1853	95	06	20
Subdivision corners	David P. Thompson	83	July 22nd 1853	60	27	77
Total number of Acres 23,287.32						

This above Map of Township N^o 2 North of Range N^o 30 East of the Willamette Meridian is correctly conformable to the field notes of the survey thereof on file in this Office which have been examined and approved.

Surveyor General's Office, Do. N. W. Chapman
 Eugene City January 31st 1860

J. S. Reed