Township 2 North Range 31 East Will. Mer. Oregon

4004

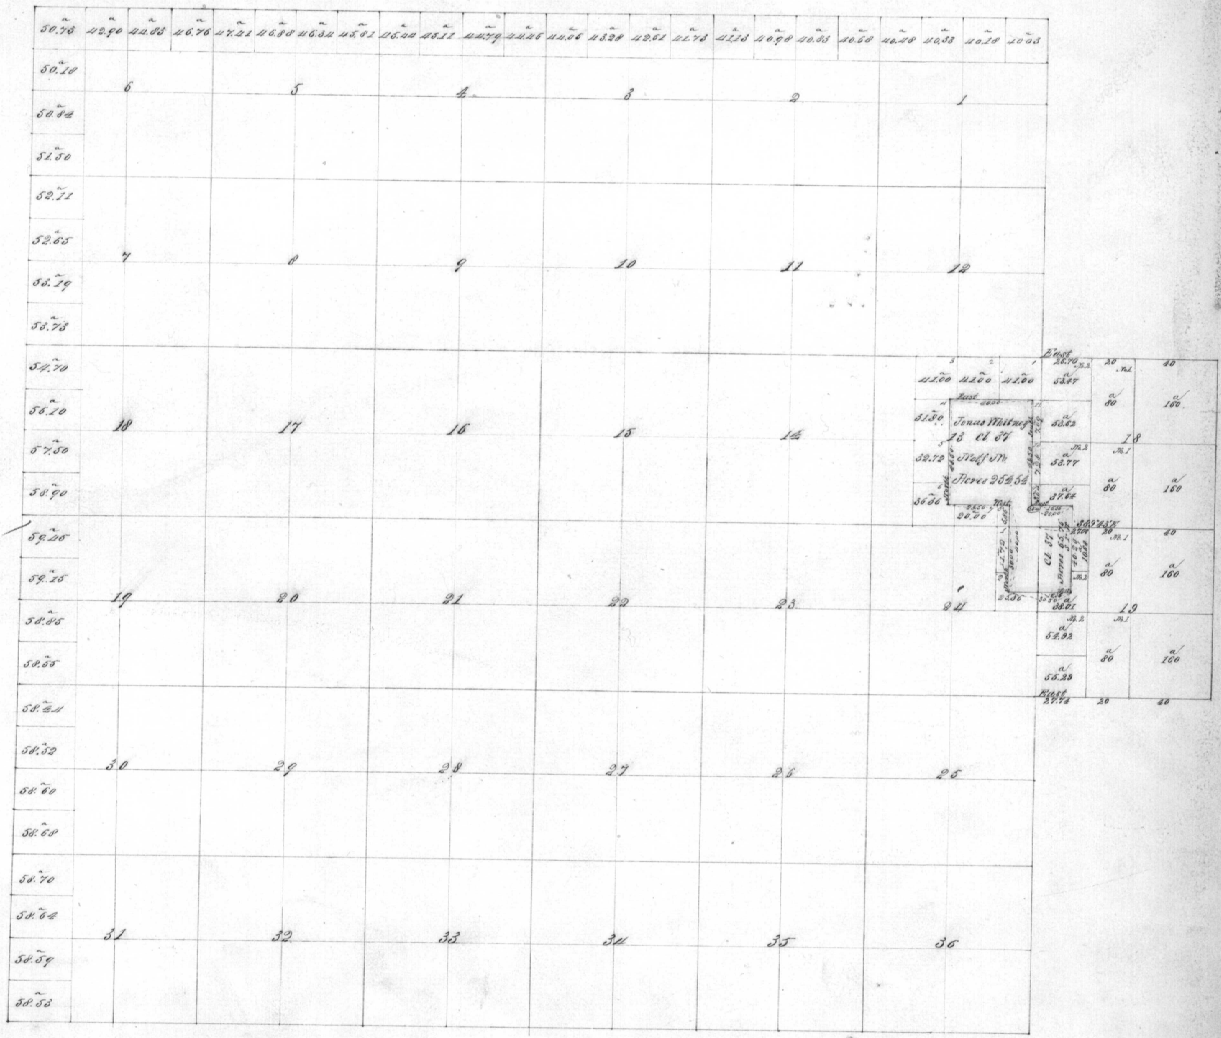

Aggregate area of Surveyed cls 264.58
" " Pub. lands 5824.24

The above sketch of the Survey of James Whitneys donation land claim in Township 2 North Range 31 East Will. Mer. Oregon is strictly conformable to the original field notes of the Survey thereof on file in this Office, which have been examined and approved.

U. S. Surveyor Generals Office.
Eugene City, Oregon
Feb 6th 1873

W. H. Odell
Surv Gen'l Oregon