


4064


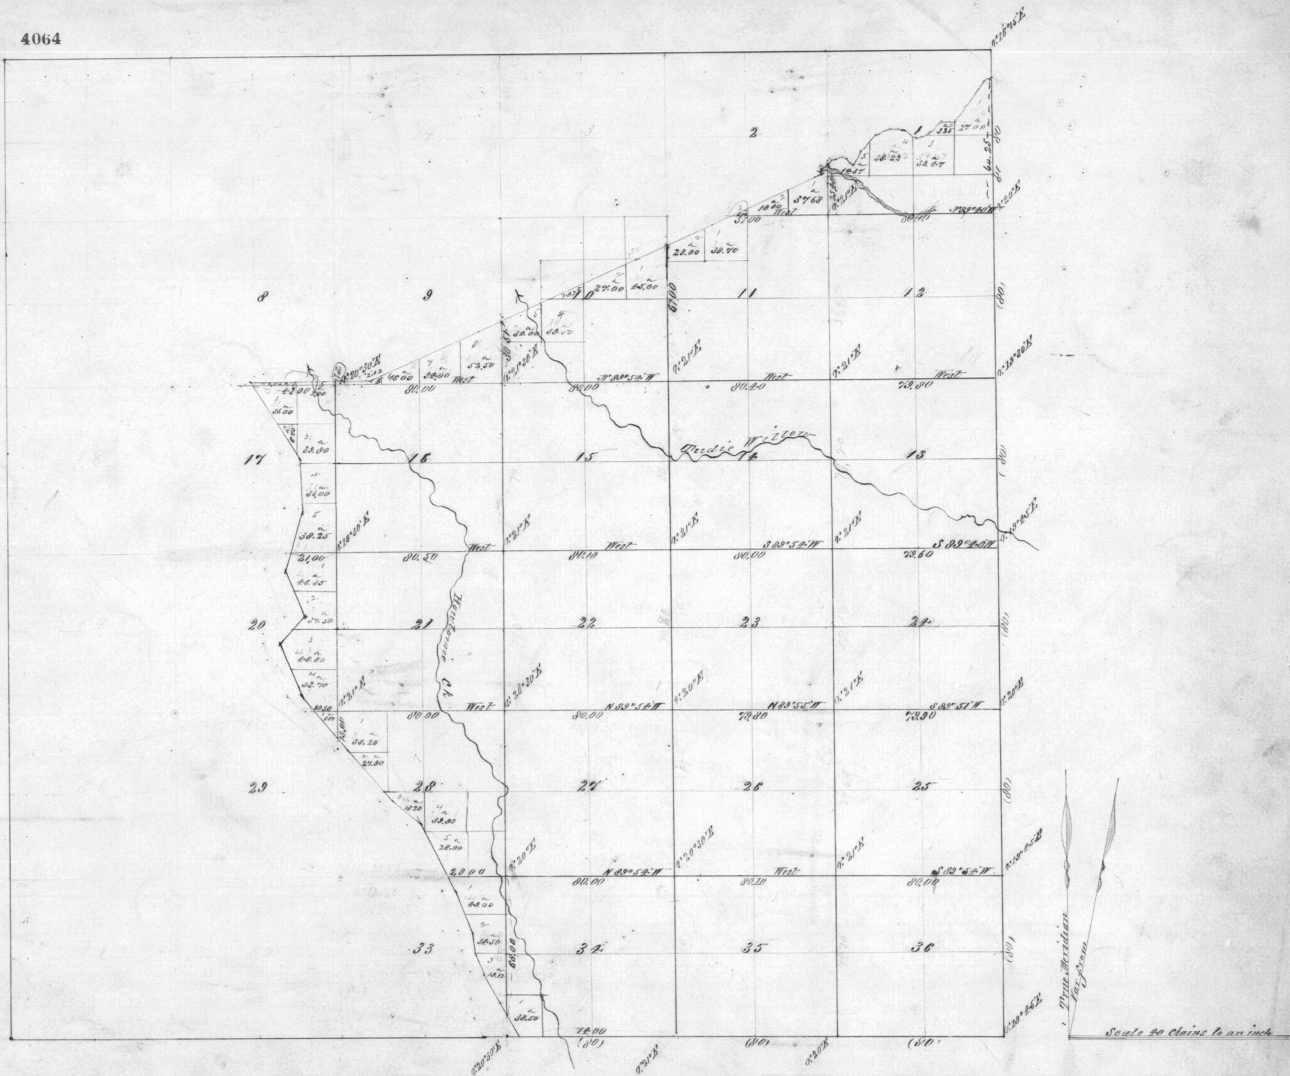

Scale 20 Chains to an inch

Line Subdivisions	Contractor	Contract Date	Amount Surveyed	Per Chain	Links	Commenced	Completed


W. H. Colwell
Surv. Gen.