

5-29-A +

Township No. 5 North Range No. 29 East Willamette Meridian.


Received with Surveyor General's letter of May 31 1867



Department of the Interior
General Land Office
Dec 20th 1883

I hereby certify that the above is a true photo-lithographic copy of the original on file in this Office.

Admission
Acting Commissioner

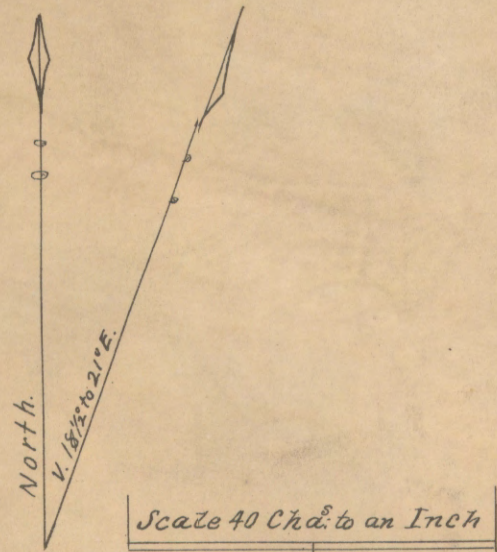

Surveys Designated	By whom Surveyed	Contract		Amt. of Surveys			When Surveyed	When chargeable in the Surveyor Genl's acct.
		No.	Date	Miles	Chs.	Lines		
E. & N. Boundaries	Edward Giddings	96	27 th Dec. 1866	7	42	11	14 th April 1867	4 th Quarter 1867
Subdivisions		Inst.	10 th March 1867	11	18	35	" " "	" " "
Meanders		"	" " "	6	36	95	" " "	" " "
Total No. of Acres		47 63.04						

The above map of Township No. 5 North of Range No. 29 East of the Willamette Meridian in the Territory of Washington is strictly conformable to the field notes of the survey thereof on file in this office which have been examined and approved.
Surveyor General's Office
Olympia, W.T. May 31st 1867
S. S. Corfield
Sur. Genl. W.T.