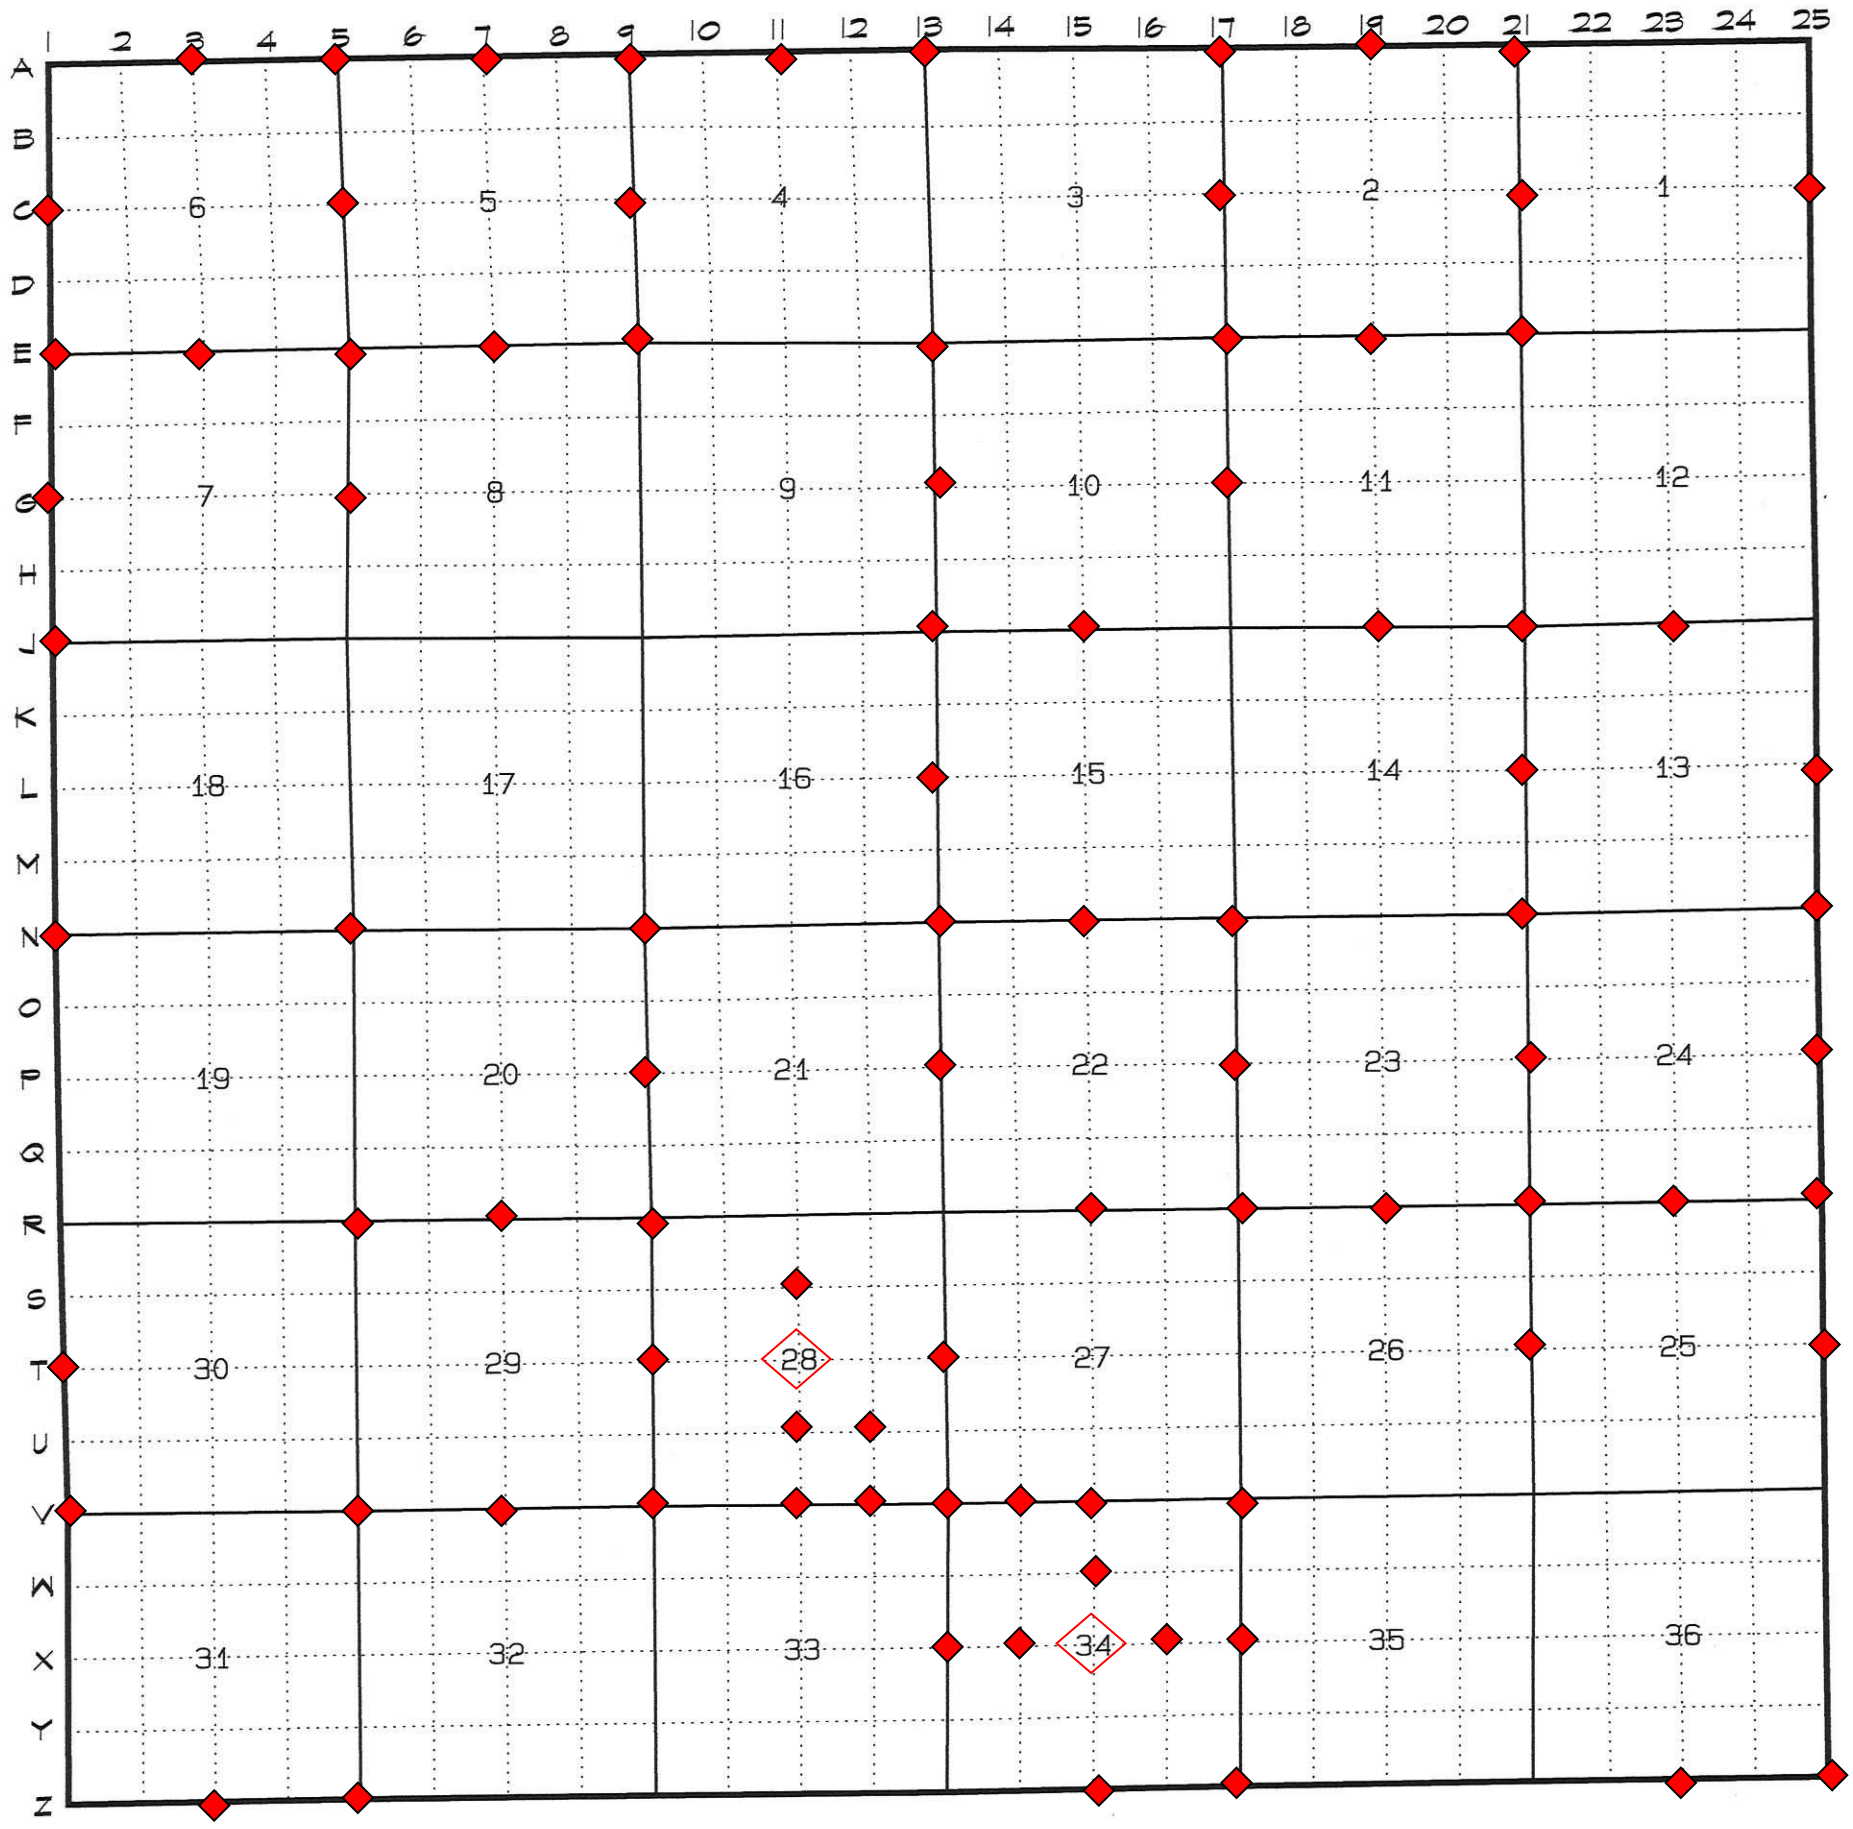TOWNSHIP 2 SOUTH RANGE 30 EAST