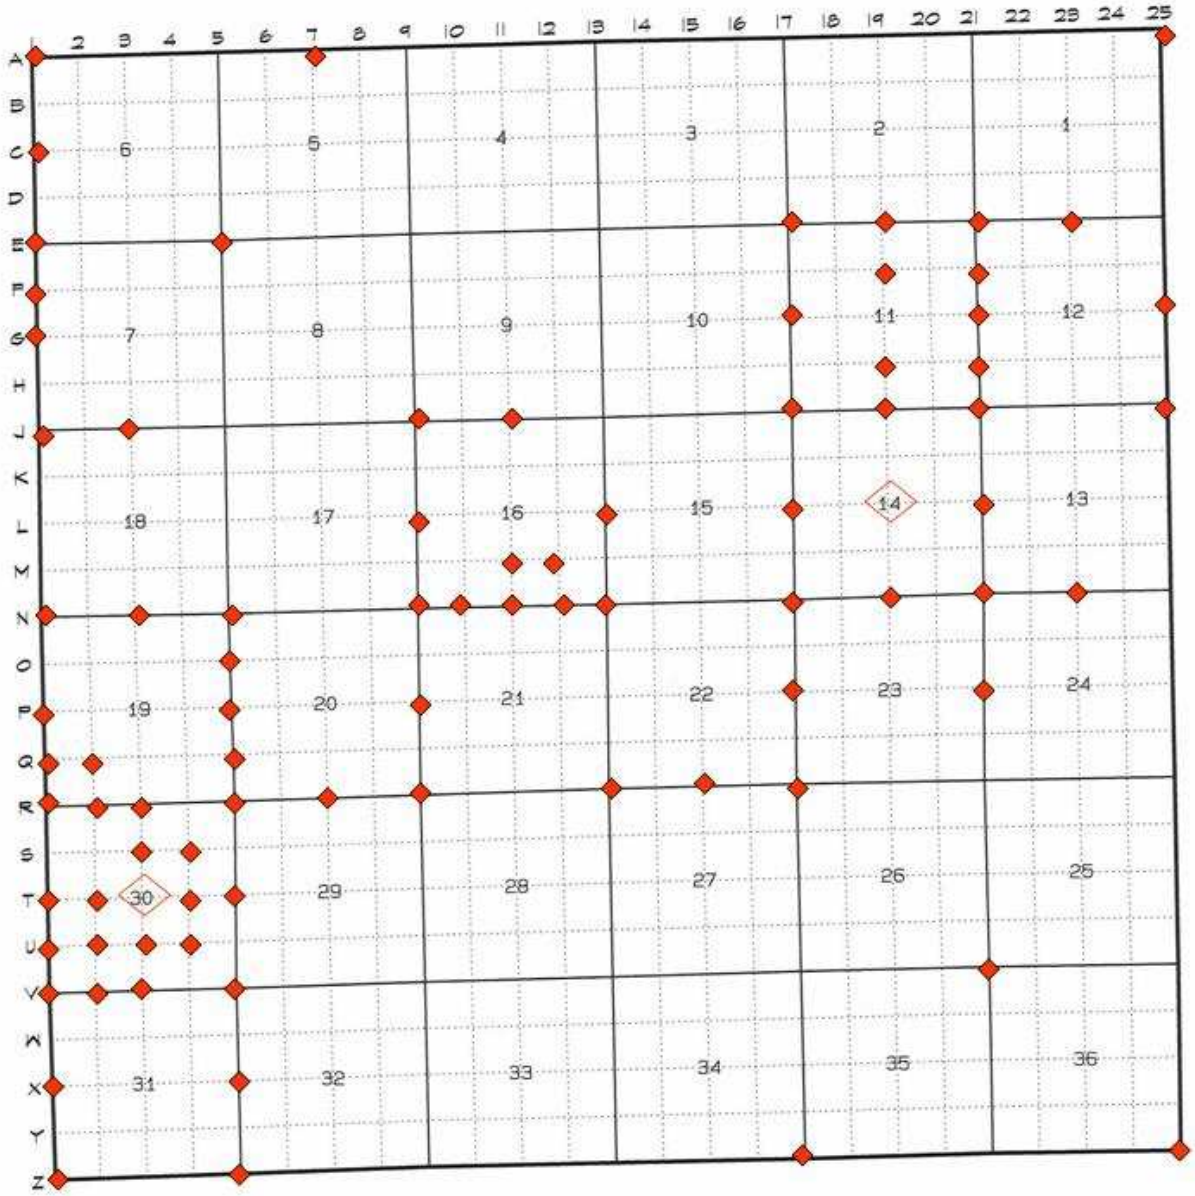TOWNSHIP 5 SOUTH RANGE 31 EAST