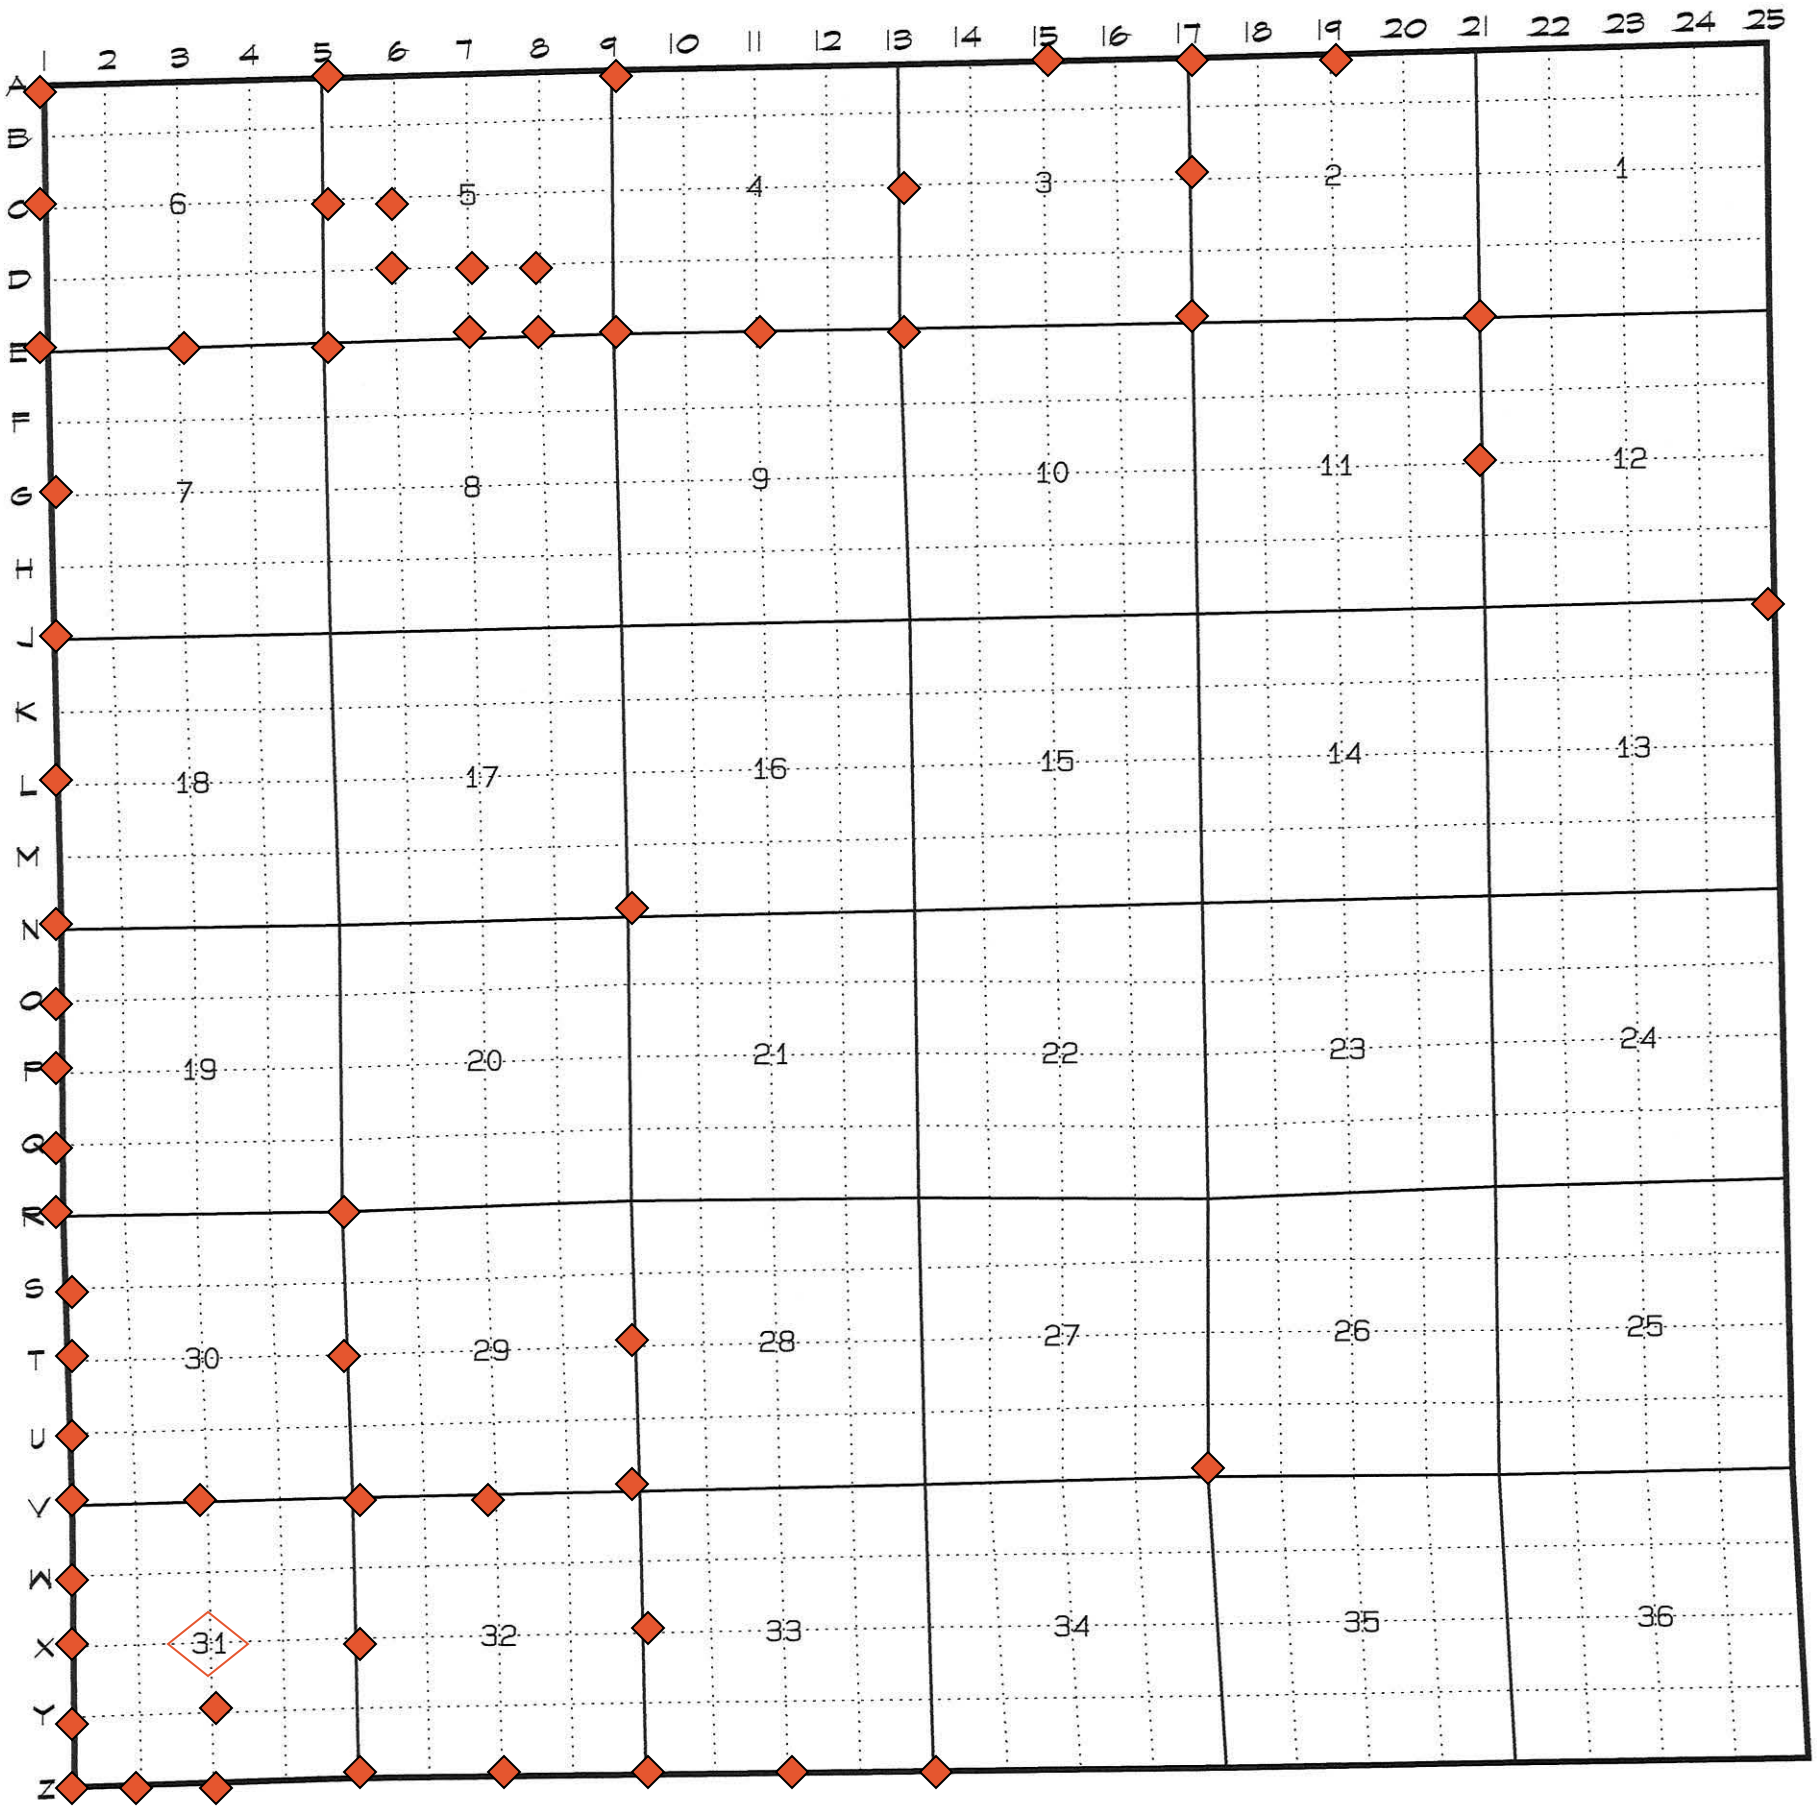TOWNSHIP 6 SOUTH RANGE 33 EAST