

Township 1 North Range 32 East

4069

51.00
41.10
92.10


70.00
36.00
106.00

38.50
8.50
47.00

2.22
2.22

24.50
30.50
15.50
70.50


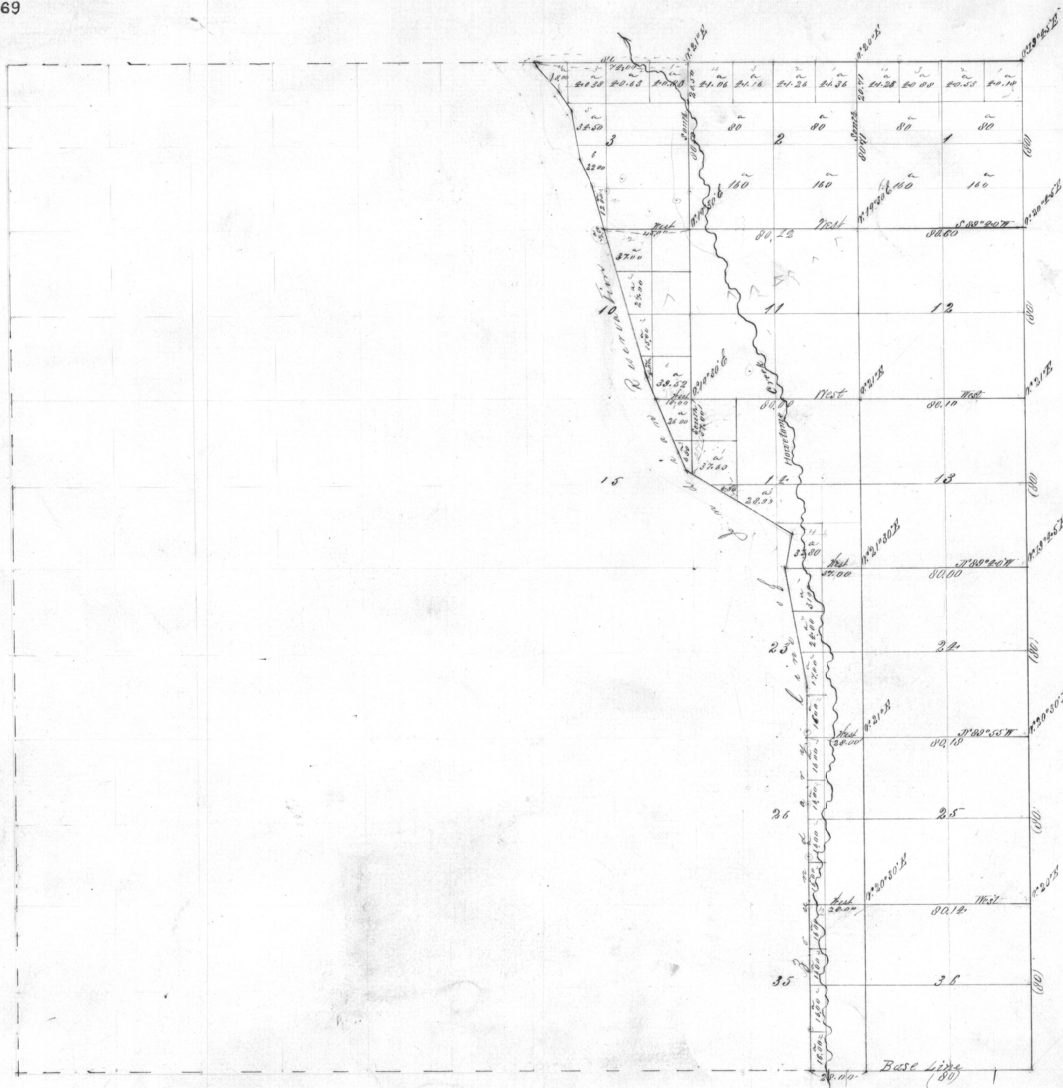

Drawn by
 Wm. J. Johnson

Scale to Chains to an inch

Lines	Contractor	Contract	Amount Surveyed	Commenced	Completed
		to Date	Miles Acres Links		
Submissions	Genas L. Long	104, Colburn 100	11 35 35	Nov 9 1871	Nov 10 1871

The above Map of Block 11 T. 1 N. R. 32 E. 1871. The Oregon is strictly conformable to the original field notes of "Strong" on file in this Office which have been examined and approved.
 Surveyor General's Office
 Eugene Ore. June 21st 1872
 Wm. J. Johnson
 Surveyor General