


Exterior & Subdivisional Lines, T.2 S., R.33 E., W.M.

Chains

Feet

I commence at S.E. Cor. to Tp. 2-S., R.32 E., which is a fir post, 4 ft. long and $3\frac{1}{2}$ ins. sq., at top, pretty well decomposed, lying loose upon the ground, by the side of an unmarked basalt stone, 8 x 6 x 5 ins., about $\frac{1}{2}$ its length in ground; the post is marked thus:

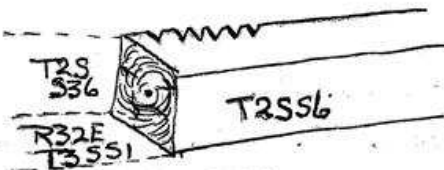

From position of stone & post,

A pine, 30 ins. diam., brs. N.58°10' E., 86 lks. dist., marked T.2 S., R.33 E., S.1, B.T.

A fir, 16 ins. diam., brs. S.37°35' E., 182 lks. dist., marked, but blazes grown over, so marks are illegible.

A pine, 30 ins. diam., brs. S.45°30' W., 204 lks. dist., marked T.2 S., R.32 E., S.1, B.T.

A pine, 20 ins. diam., brs. N.20°35' W., 112 lks. dist., marked T.2 S., R.32 E., S.36, B.T.

On summit of high ridge at S. edge of sage brush thicket.

Thence I run

N. on E. Bdy. of Sec. 36.

Var. 18°30' E.

Following on this line are the original blazed trees:-

- 11.50 Descend steep hill.
- 13.00 Enter thicket of tamarack; find blazed trees on line.
- 15.03 Search diligently; but find no traces of Closing Tp. Cor., as reported and the topography does not agree.
- 20.00 The topography agrees with that reported; I set post, marked 20 on S. side, on line, marked by old blazes on trees, and go to $\frac{1}{4}$ Sec. Cor. on N. Bdy. of Sec. 5, T.3 S., R.33 E., which is a pine post, 4 ft. long and 4 ins. diam., marked $\frac{1}{4}$ S., lying on the ground by mound of stone, at upper edge of grove of young tamarack trees, on W. slope of hill, from which,
- A pine, 6 ins. diam., brs. S.64°W., 91 lks. dist.,