


1	100.00
2	100.00
General Description

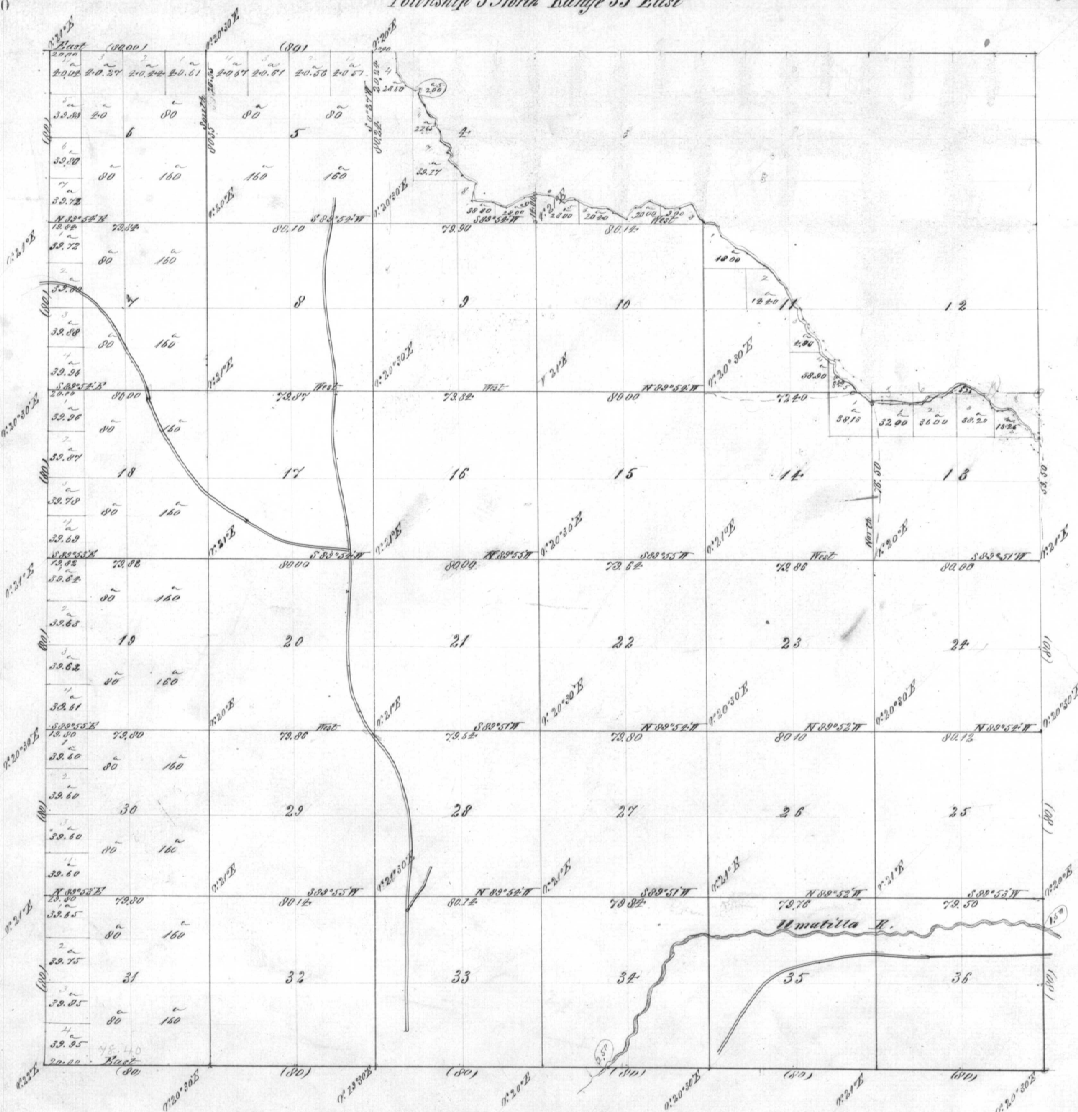

Scale 20 Chains to an inch

Lines	Contractor	32	600 Acres	General Survey	Commenced	Completed
Subdivisions	J. S. Moody	100	October 1874	53 01 00	October 18 1877	October 23 1877

 Eugene July 23 1877

M. H. Odece
 Surveyor General of Or.